



T.4S. R.1E. Section 31, W.M.

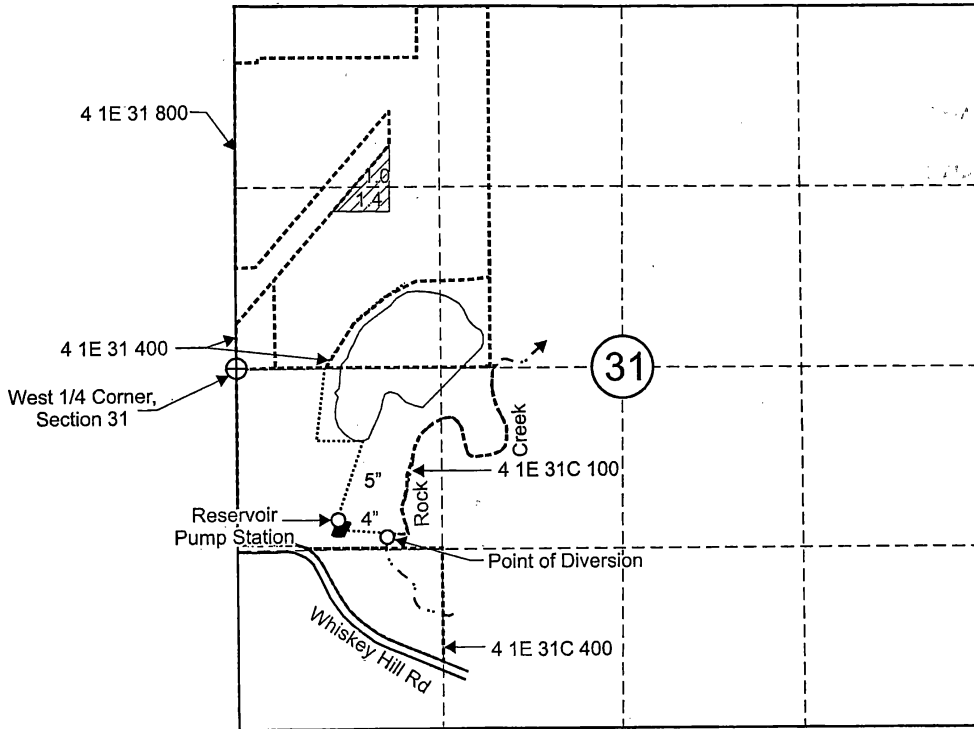

Authorized Point of Diversion is located 1,240 feet south and 1,090 feet west from the west 1/4 corner, Section 31.

 Area (2.4 acres) Irrigated under T-11968.


----- Tax lot boundary

..... Mainline

RECEIVED

NOV 17 2017


OWRD

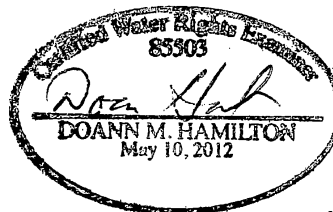

RENEW June 30 2019



Scale: 1" = 1,320'

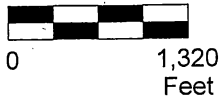

This map was prepared for the purpose of identifying the location of a water right only and is not intended to provide legal dimensions or location of property ownership lines.

Claim of Beneficial Use Map
T-11968

Warren Bean
T.4S. R.1E. Section 31, W.M

Pacific Hydro-Geology Inc.

11/2017