


**T24S, R33E, SECTION 18**

HARNEY COUNTY, OREGON

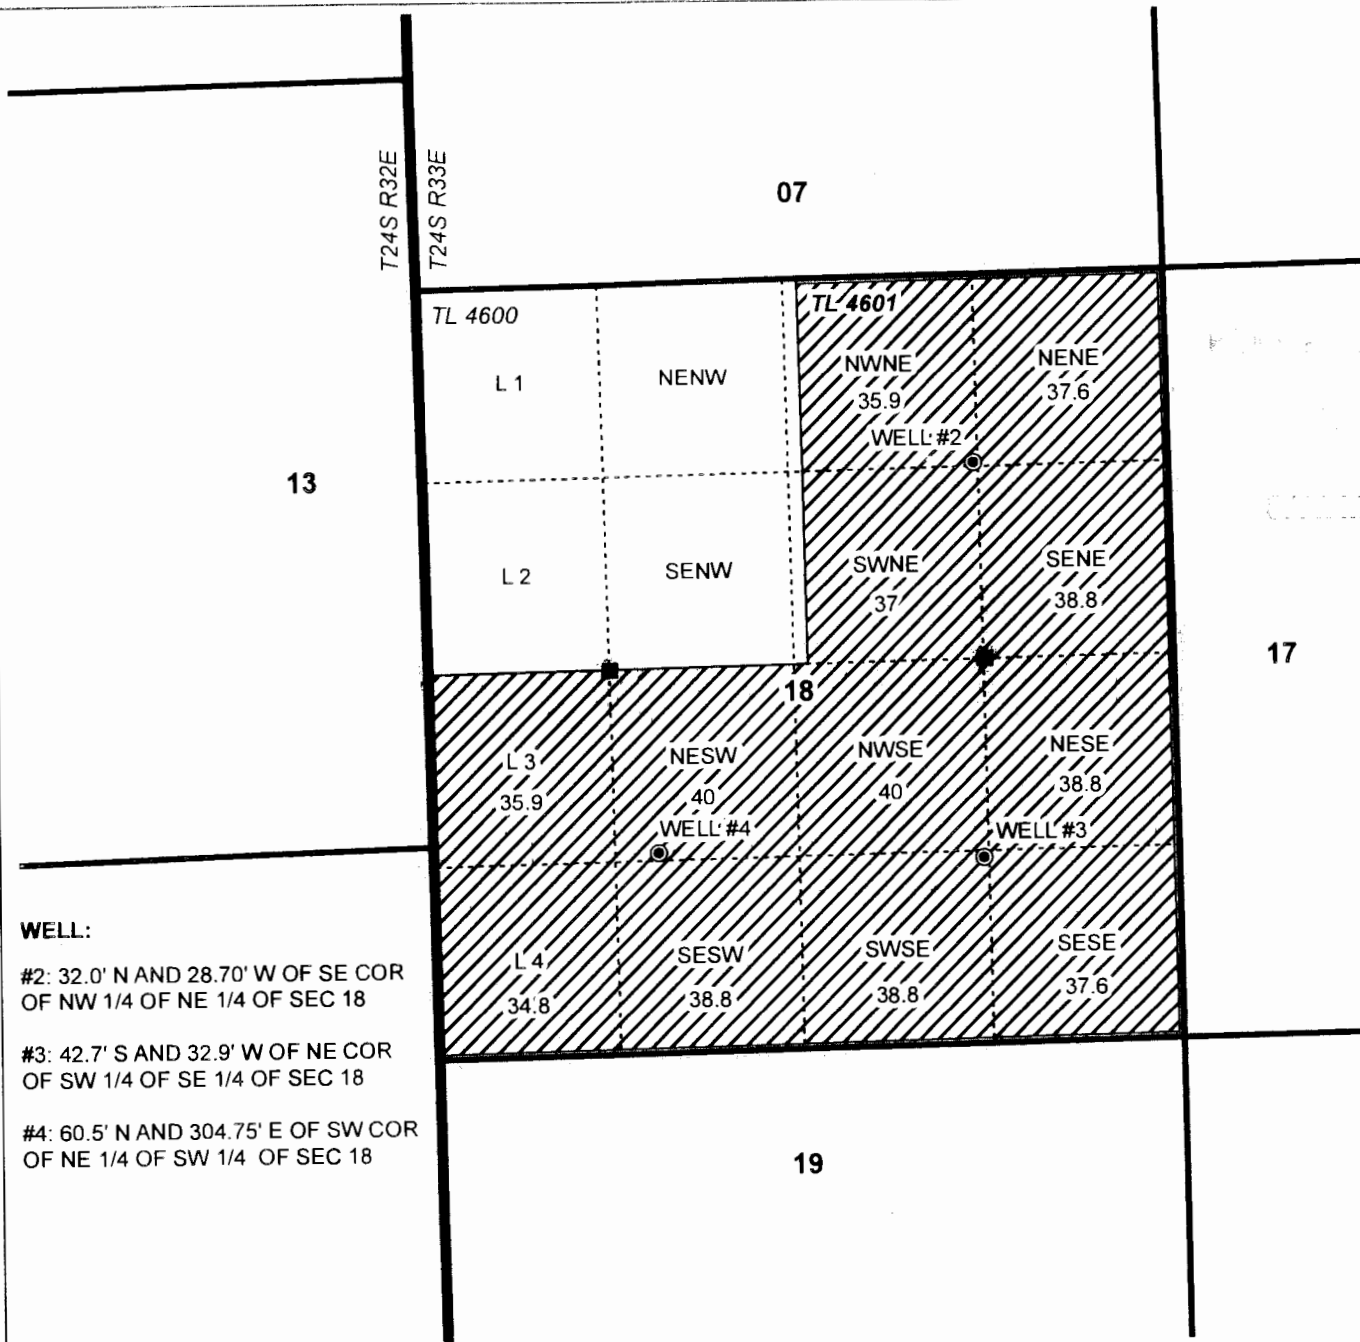









**WELL:**

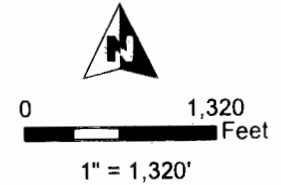
#2: 32.0' N AND 28.70' W OF SE COR OF NW 1/4 OF NE 1/4 OF SEC 18

#3: 42.7' S AND 32.9' W OF NE COR OF SW 1/4 OF SE 1/4 OF SEC 18

#4: 60.5' N AND 304.75' E OF SW COR OF NE 1/4 OF SW 1/4 OF SEC 18



-  POU Irrigation
-  Township
-  Section
-  Quarter Quarter
-  Tax Lot
-  Well
-  Meter

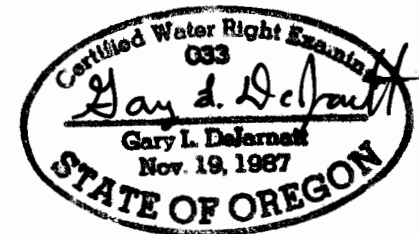

RENEWAL DATE 12/31/2017



**CLAIM OF BENEFICIAL USE MAP**  
**Matthew Stashin**

NOTE: THIS MAP IS NOT INTENDED TO PROVIDE LEGAL DIMENSIONS OR LOCATIONS OF PROPERTY OWNERSHIP LINES.

**WATER RIGHT SERVICES, LLC**  
PO BOX 1830, BEND, OR 97709  
CCB# 197121 [www.oregonwater.us](http://www.oregonwater.us)  
541-389-2837 [JOHNSHORT@USA.COM](mailto:JOHNSHORT@USA.COM)

AP G-7079

PERMIT G-17595

DEC 5, 2016

JOB 16007

# T24S, R33E, SECTION 18

HARNEY COUNTY, OREGON

T24S R32E  
T24S R33E

07

13

TL 4600

L 1

NENW

TL 4601

6.1

NWNE

5.3

29.8

NENE

32.3

WELL #2

Text

124.4

SWNE

SENE

29.9

32.4

L 2

SENW

7.1

6.4

18

17

7.1

L 3

NESW

10.2

8.6

NWSE

NESE

28.8

29.8

31.4

31.4

WELL #4

WELL #3

28.7

29.7

31.4

31.4

6.1

L 4

SESW

9.1

7.4


19

WELL:

#2: 32.0' N AND 28.70' W OF SE COR OF NW 1/4 OF NE 1/4 OF SEC 18

#3: 42.7' S AND 32.9' W OF NE COR OF SW 1/4 OF SE 1/4 OF SEC 18

#4: 60.5' N AND 304.75' E OF SW COR OF NE 1/4 OF SW 1/4 OF SEC 18

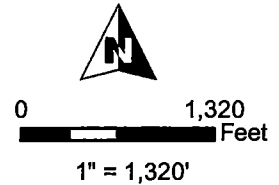

- POU IR Remaining
- POU IR OFF
- Township
- Section
- Quarter Quarter
- Tax Lot
- Well

RECEIVED BY OWRD

DEC 29 2017

SALEM, OR



RENEWAL DATE 12/31/2018

## TRANSFER "OFF" MAP

Matthew Stashin

CERT 92313

NOTE: THIS MAP IS NOT INTENDED TO PROVIDE LEGAL DIMENSIONS OR LOCATIONS OF PROPERTY OWNERSHIP LINES.

DEC 2, 2017

## WATER RIGHT SERVICES, LLC

PO BOX 1830, BEND, OR 97709

CCB# 197121 [www.oregonwater.us](http://www.oregonwater.us)

541-389-2837 [JOHNSHORT@USA.COM](mailto:JOHNSHORT@USA.COM)

1-12812