

Claim of Beneficial Use

Vasily B. Ivanov

Application # G-16418

Permit # G-15994


SE 1/4 SW 1/4

Sec. 5 T. 5 S., R. 1 E., W.M.

Clackamas County, Oregon

Scale: 1"=400'

North

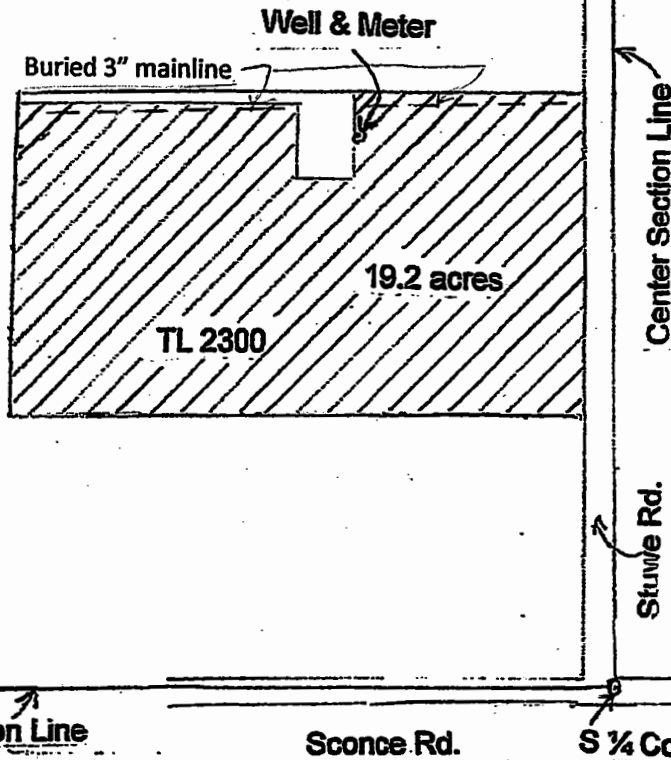

RECEIVED

JUN 23 2015

WATER RESOURCES DEPT
SALEM, OREGON

THIS MAP WAS PREPARED SOLELY FOR
THE PURPOSE OF DEPICTING THE LOCATION
OF A WATER RIGHT, AND HAS NO INTENTION
OF BEING USED TO DETERMINE REAL
PROPERTY BOUNDARIES.



EXPIRES 6/30/2016

Surveyed April 21, 2015
Thompson M. Warren
CWRE # 139

Well & Meter Location:
1240 ft. N., 460 ft. W.
from S 1/4 Cor. Sec. 5