
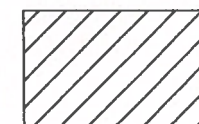


FINAL PROOF SURVEY



APPLICATION NO. G-13581

PERMIT NO. G-12559

FOR A PARCEL OF LAND SITUATED IN THE SE 1/4 OF SEC. 18, T15S, R10E, W.M., DESCHUTES COUNTY, OREGON

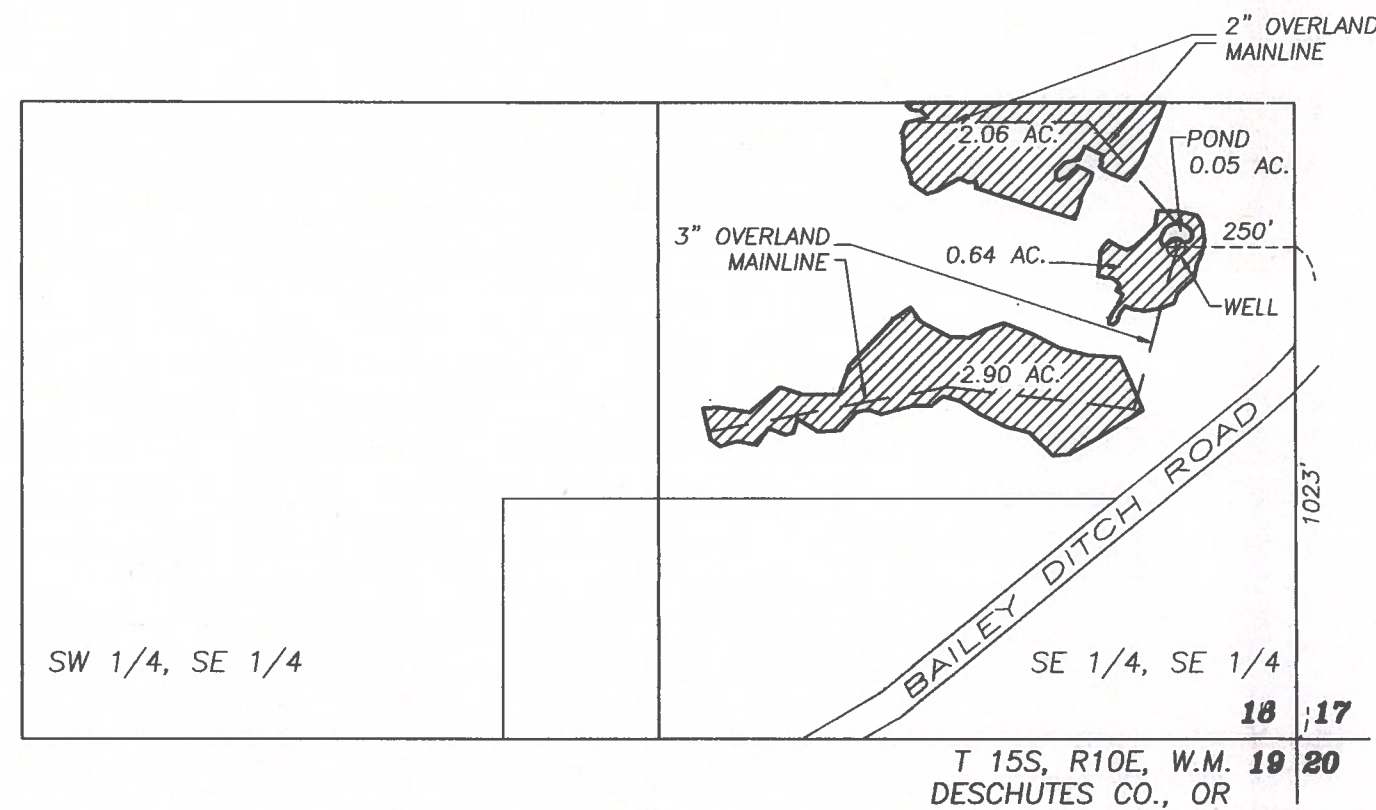


IRRIGATED AREA

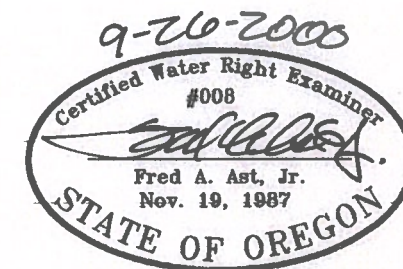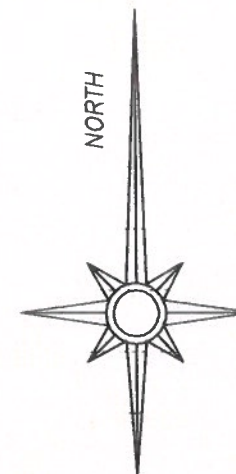

RECEIVED

SEP 29 2000

WATER RESOURCES DEPT.
SALEM, OREGON

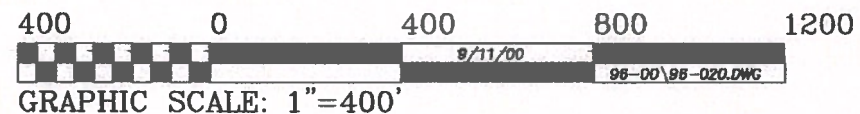

Fred A. Ast, Jr. and Associates

250 W. Cascade Avenue

P.O. Box 751

Sisters, Oregon 97759

541-549-7851