


**CLAIM OF BENEFICIAL USE MAP
WEAVER SPRING RESERVOIR
PERMIT R-12908
TRAVIS AND KELLY SINGHOSE
LOCATED IN THE SW 1/4 SW 1/4 OF SECTION 22,
TOWNSHIP 25 SOUTH, RANGE 30 EAST., W.M., HARNEY COUNTY, OREGON**

RECEIVED BY OWRD

MAY 22 2015

SALEM, OR

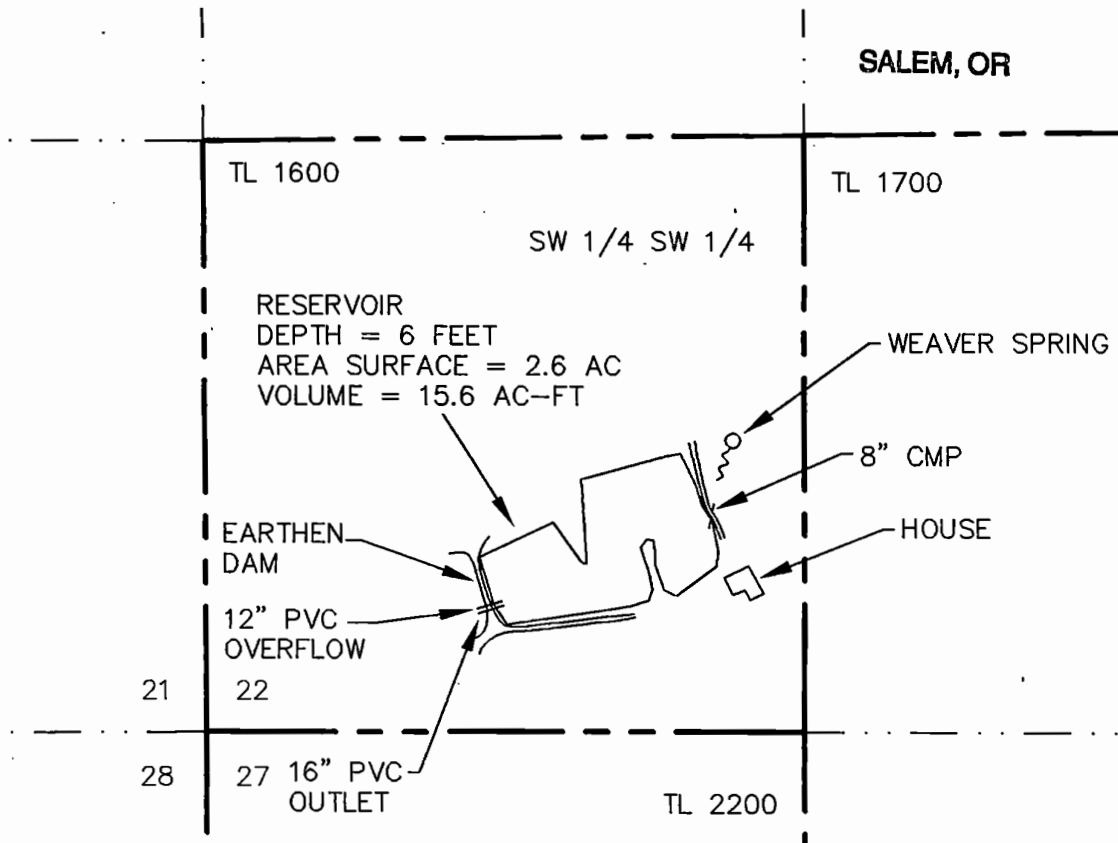

RENEWAL: JUNE 30, 2016

I, WILLIAM R. TYE, CERTIFIED WATER RIGHT EXAMINER IN THE STATE OF OREGON, HEREBY CERTIFY THE ABOVE CLAIM OF BENEFICIAL USE MAP WAS PREPARED UNDER MY DIRECT SUPERVISION. THE PREPARATION OF THIS MAP IS FOR THE PURPOSE OF IDENTIFYING THE LOCATION OF THE WATER RIGHT ONLY AND HAS NO INTENT TO PROVIDE DIMENSIONS OR LOCATIONS OF PROPERTY OWNERSHIP LINES.

TYE ENGINEERING, INC.

725 NW HILL, BEND, OREGON 97701 (541) 389-6959

DATE: MARCH 25, 2015

SCALE: 1"=400'

DRAWN BY: P.A.T.

1923-WR-FINAL.DWG