


917

COBU MAP # 917
folder I

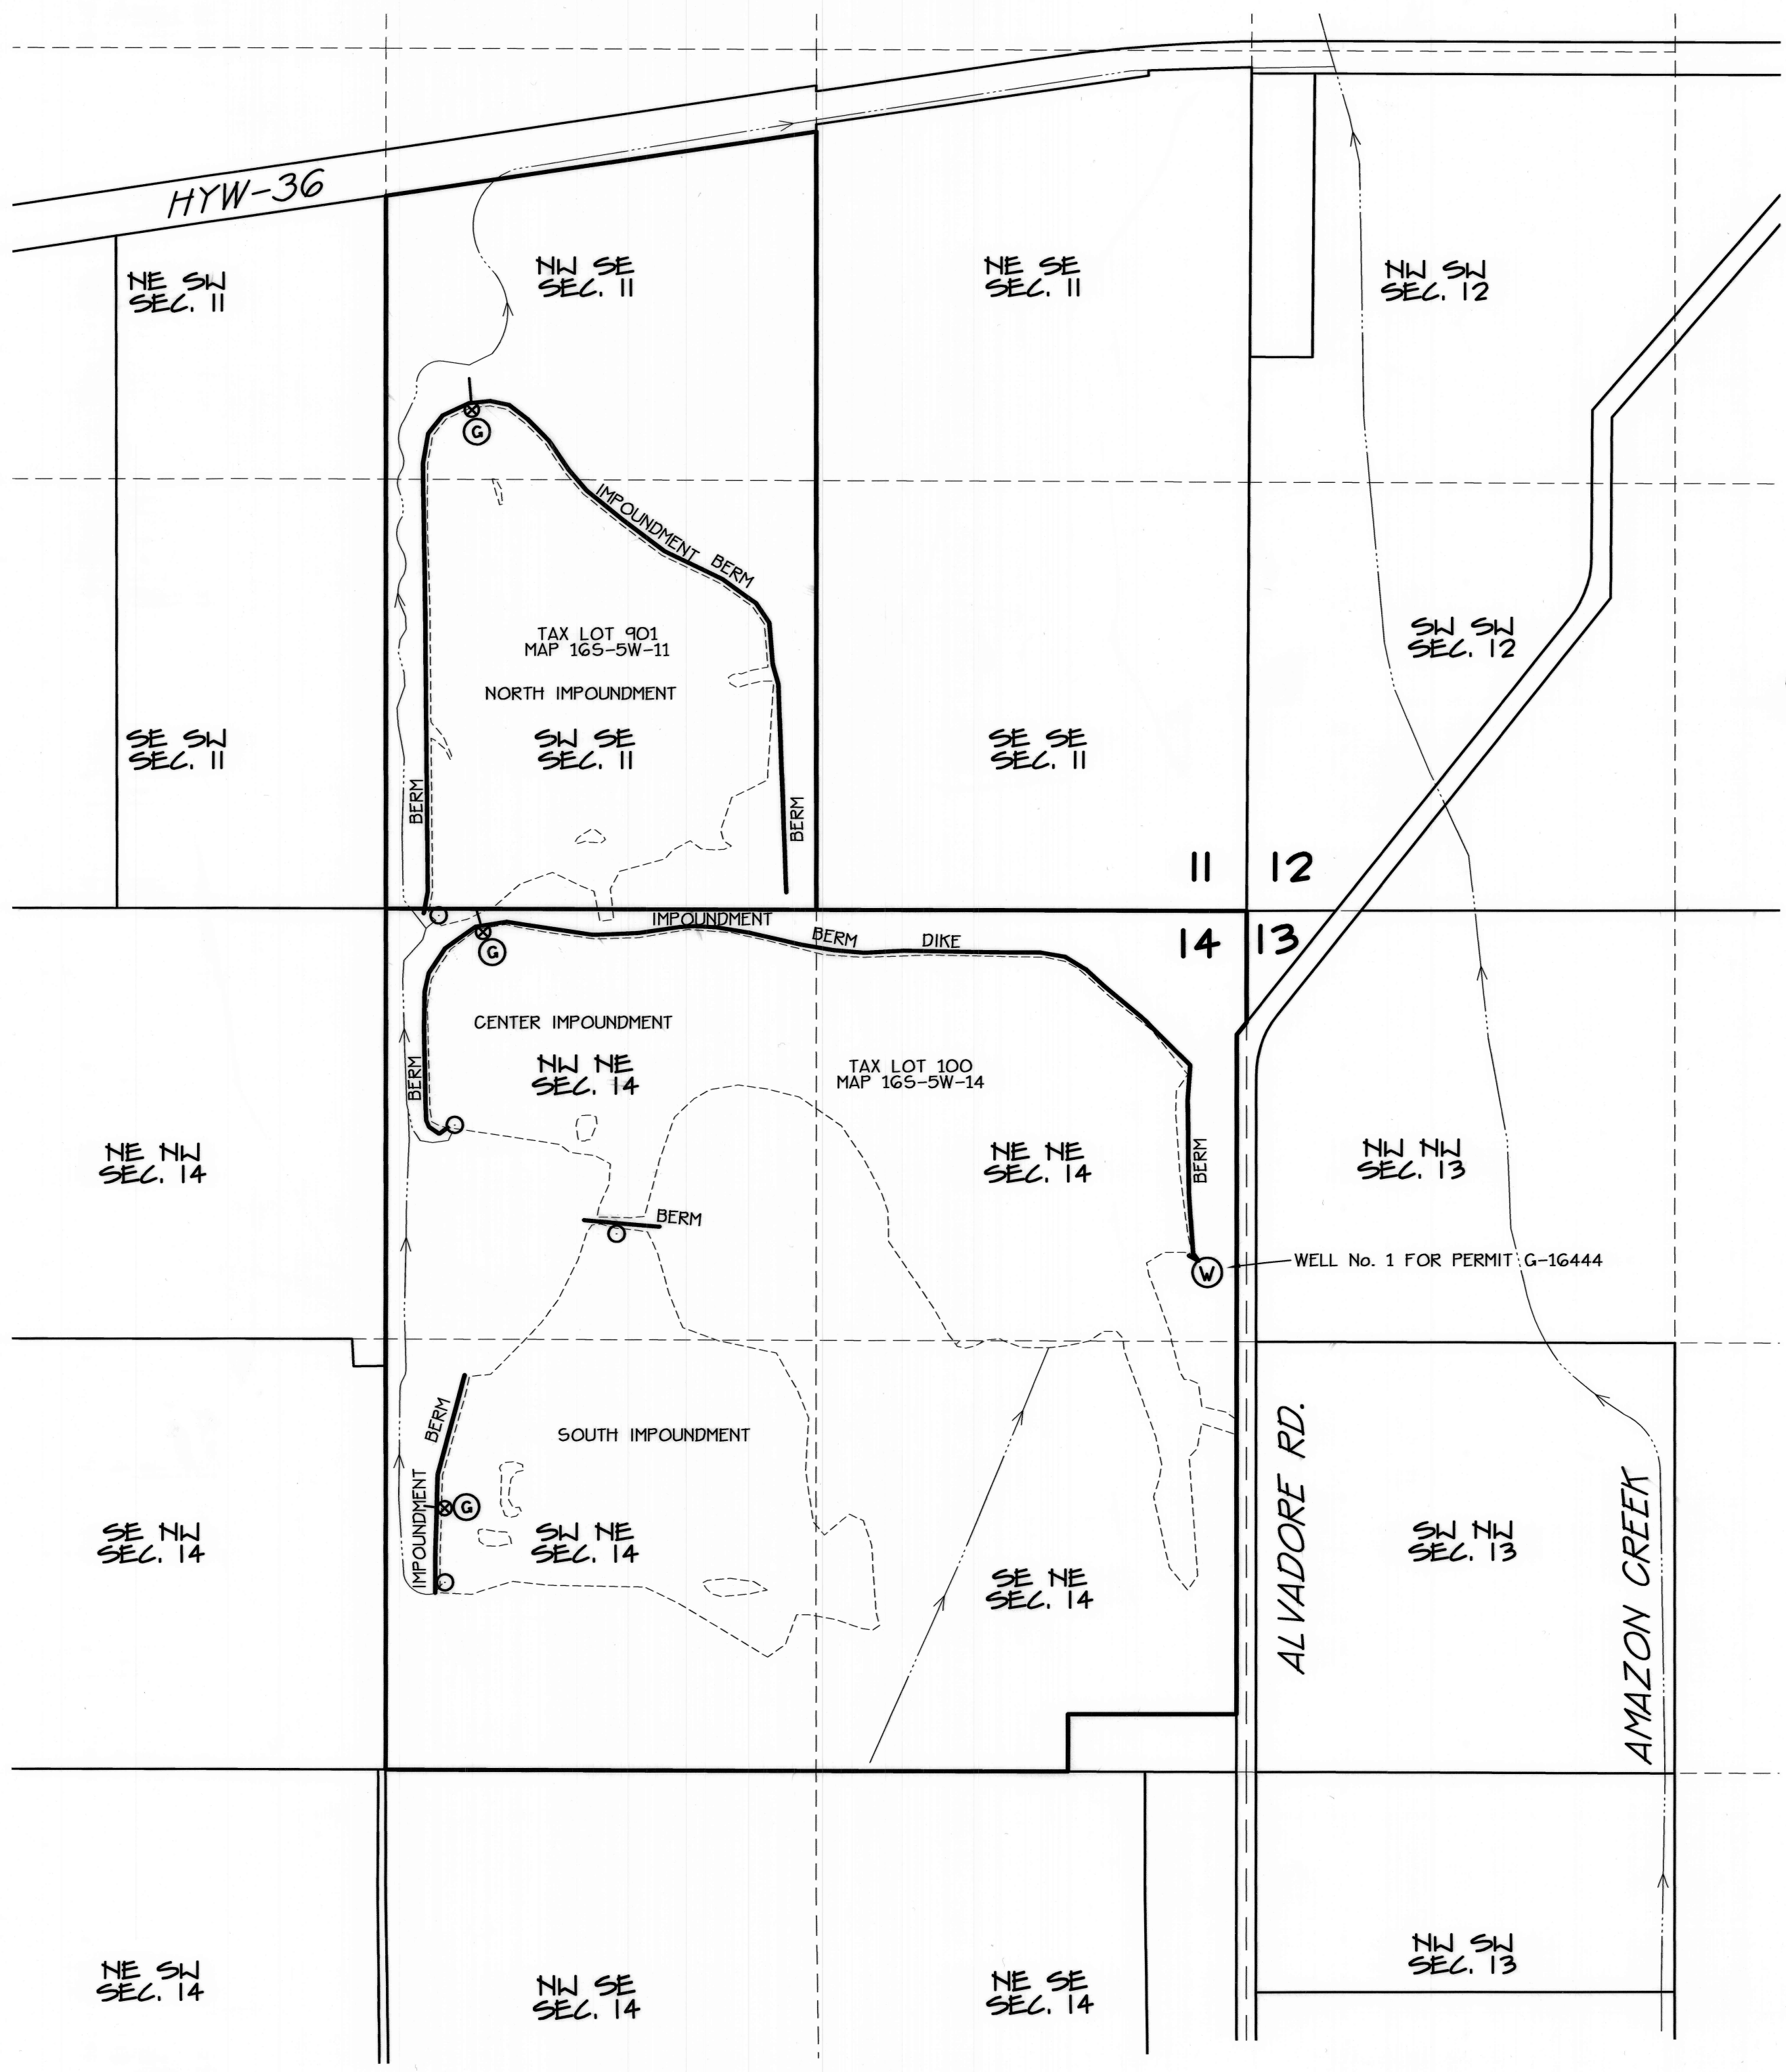


CLAIM OF BENEFICIAL USE MAP
FOR
KAWONU ACRES, LLC.

LOCATED IN
SW 1/4 SEC. 11 + NW 1/4 SEC. 14,
T. 16 S., R. 5 W., W.M.

IN
LANE COUNTY, OREGON

JUNE 16, 2015

PERMIT No. R-13297
APPLICATION No. R-85011

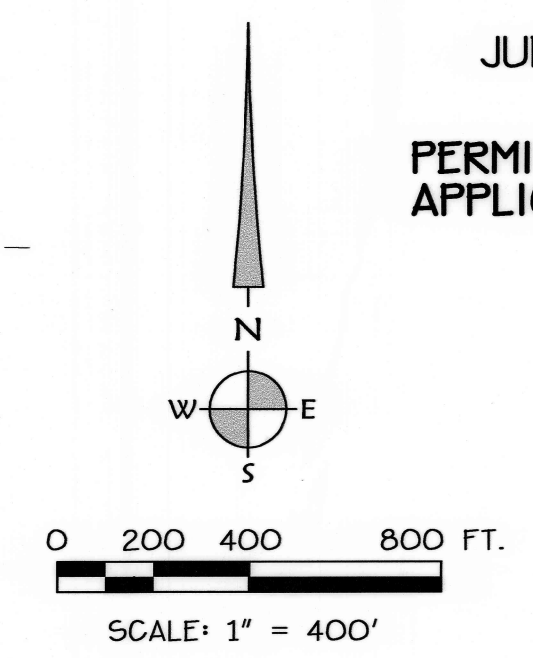

PERMITTEE:

DALE BERGEY
34033 MOUNT TOM DR.
HARRISBURG, OR 97446

SITE ADDRESS:

NONE ASSIGNED

TAX LOTS:

TAX LOT 100 (MAP 16S-5W-14)
TAX LOT 901 (MAP 16S-5W-11)

PRIORITY DATE:

JANUARY 23, 2002

LEGEND:

- W WELL No. 1 (LANE #67020)
- ⊗ WATER CONTROL STRUCTURE
- HIGH RAINFALL EVENT SPILLWAY
- G STAFF GAUGE

DISCLAIMER:

THIS MAP IS NOT INTENDED TO PROVIDE
LEGAL DIMENSIONS OR LOCATIONS OF
PROPERTY OWNERSHIP LINES

K & D ENGINEERING, Inc.
276 N.W. Hickory Street P.O. Box 725
Albany, Oregon 97321
(541) 928-2583
Date: 6/16/2015 Time: 8:48
Scale: 1=400(FS)
File: dwg\2011\11-131\11-131c\cobu-reservoir.dwg (lan)

RECEIVED

JUN 26 2015

WATER RESOURCES DEPT
SALEM, OREGON