


Claim of Beneficial Use Point of Diversion Map

Application S-88402, Permit S-55091

Township 17 South, Range 16 East (W.M.)

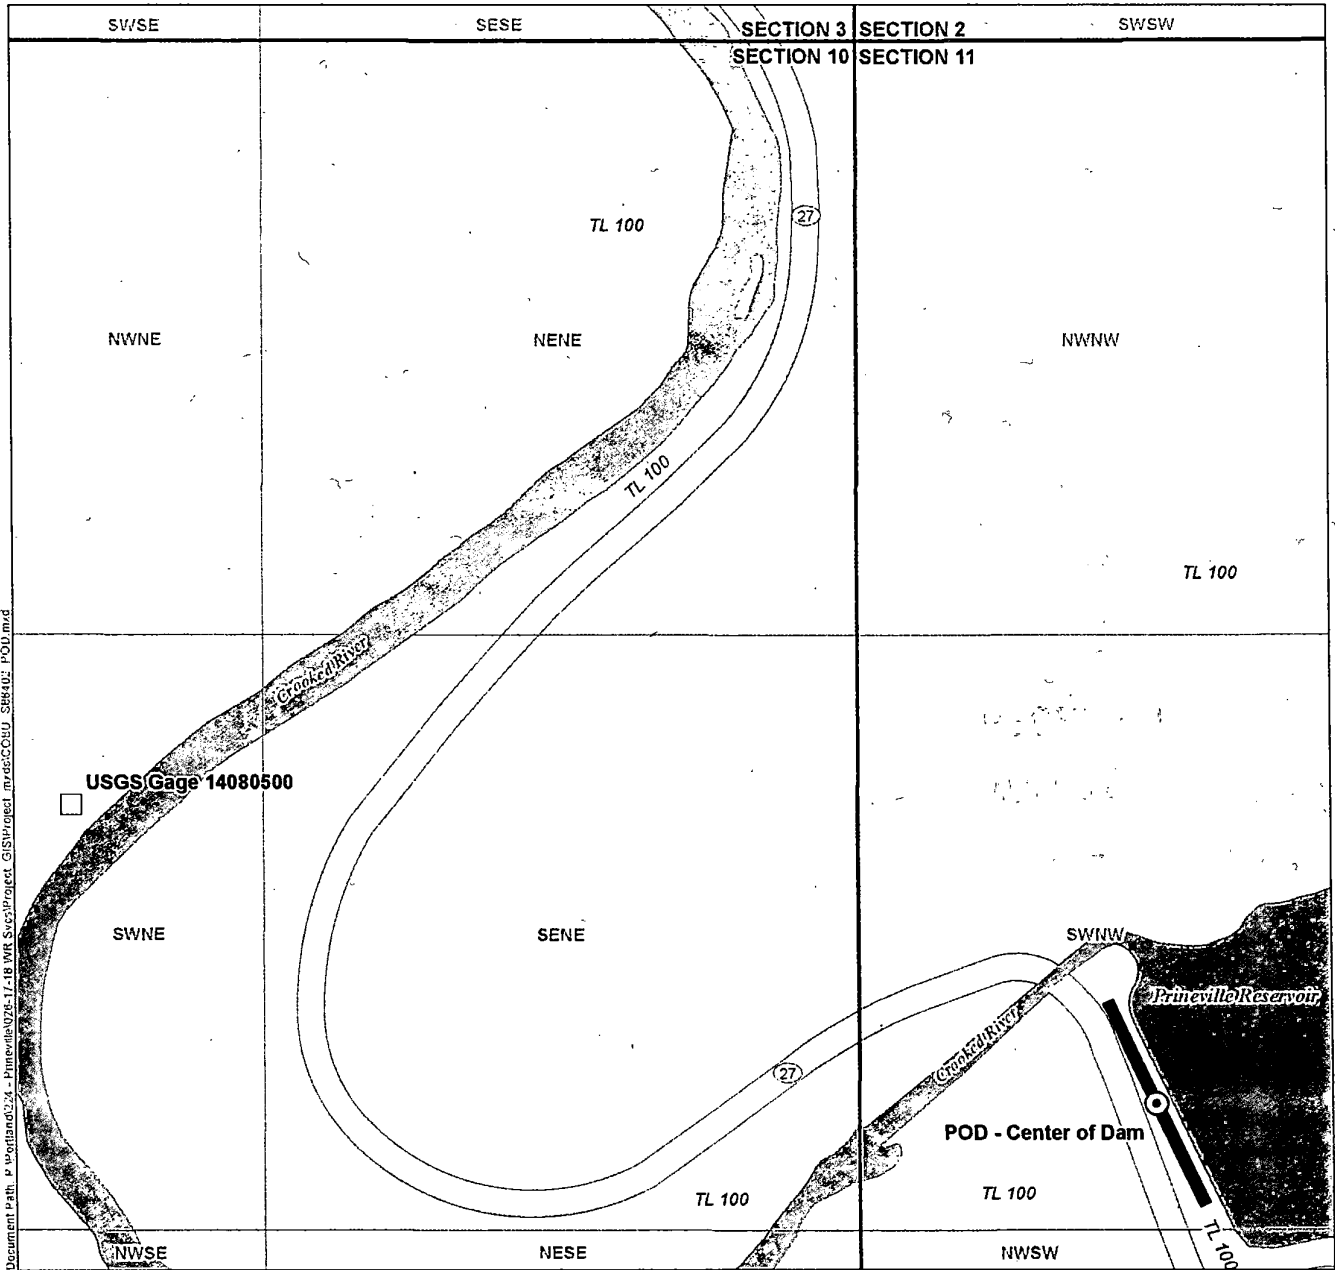

Document Path: P:\Projects\2017-18 WRR Survey\Project_GIS\Project_mxd\CCRU_SRR402_POD.mxd

LEGEND


- Point of Diversion (POD)
- Measurement Device
- Bowman Dam
- Tax Lot
- Waterbody

LOCATION DESCRIPTION

POD - Center of Dam
 Located 2,350 feet South and 650 feet East from the NW Corner of Section 11, Township 17 South, Range 16 East (W.M.)

Measurement Device
 Located 660 feet North and 2,340 feet West from the Center of the Dam, Section 10, Township 17 South, Range 16 East (W.M.)

Certified Water Rights Examiner Stamp

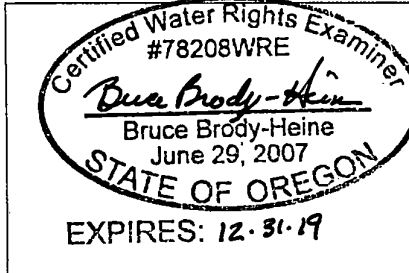

DISCLAIMER

This map was prepared for the purpose of identifying the location of a water right only and it is not intended to provide legal dimensions or location of property ownership lines.

MAP NOTES

Date: May 18, 2018
 Data Sources: Crook Co. GIS, USGS, OGIC

