


T. 1 N., R. 43 E., W.M.

SCALE: 1" = 1320'

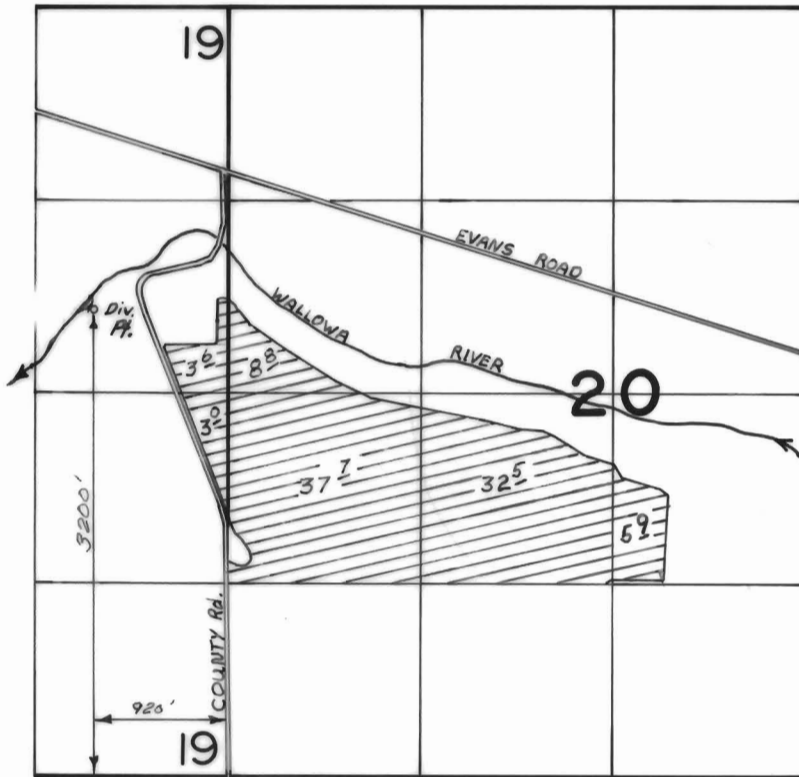


 
 





FINAL PROOF SURVEY UNDER

Application No. 59465 Permit No. 44750.....
IN NAME OF

.....THOMAS J. WILLETT.....

Surveyed Aug. 8..... 1985., by V.L. CHURCH.....

Instream Transfer Map C62054, C93523, C93533

-  62054 acres to be transferred
-  93523 acres to be transferred
-  93533 acres to be transferred
-  62054 Remaining
-  93523 Remaining
-  Wolfe Taxlots
-  Tulley Hill Ditch
-  Wolfe PODs

Wallowa POD Description: SE 1/4 NE 1/4, Section 19; 3200 North and 920 feet West of SE corner section 19

Tulley Hill POD Description: SE 1/4 NW 1/4, Section 29; 1080 North and 2559 feet West of SW corner section 29

