


**T27S, R34E,
SECTION 6, WM**

HARNEY COUNTY, OREGON

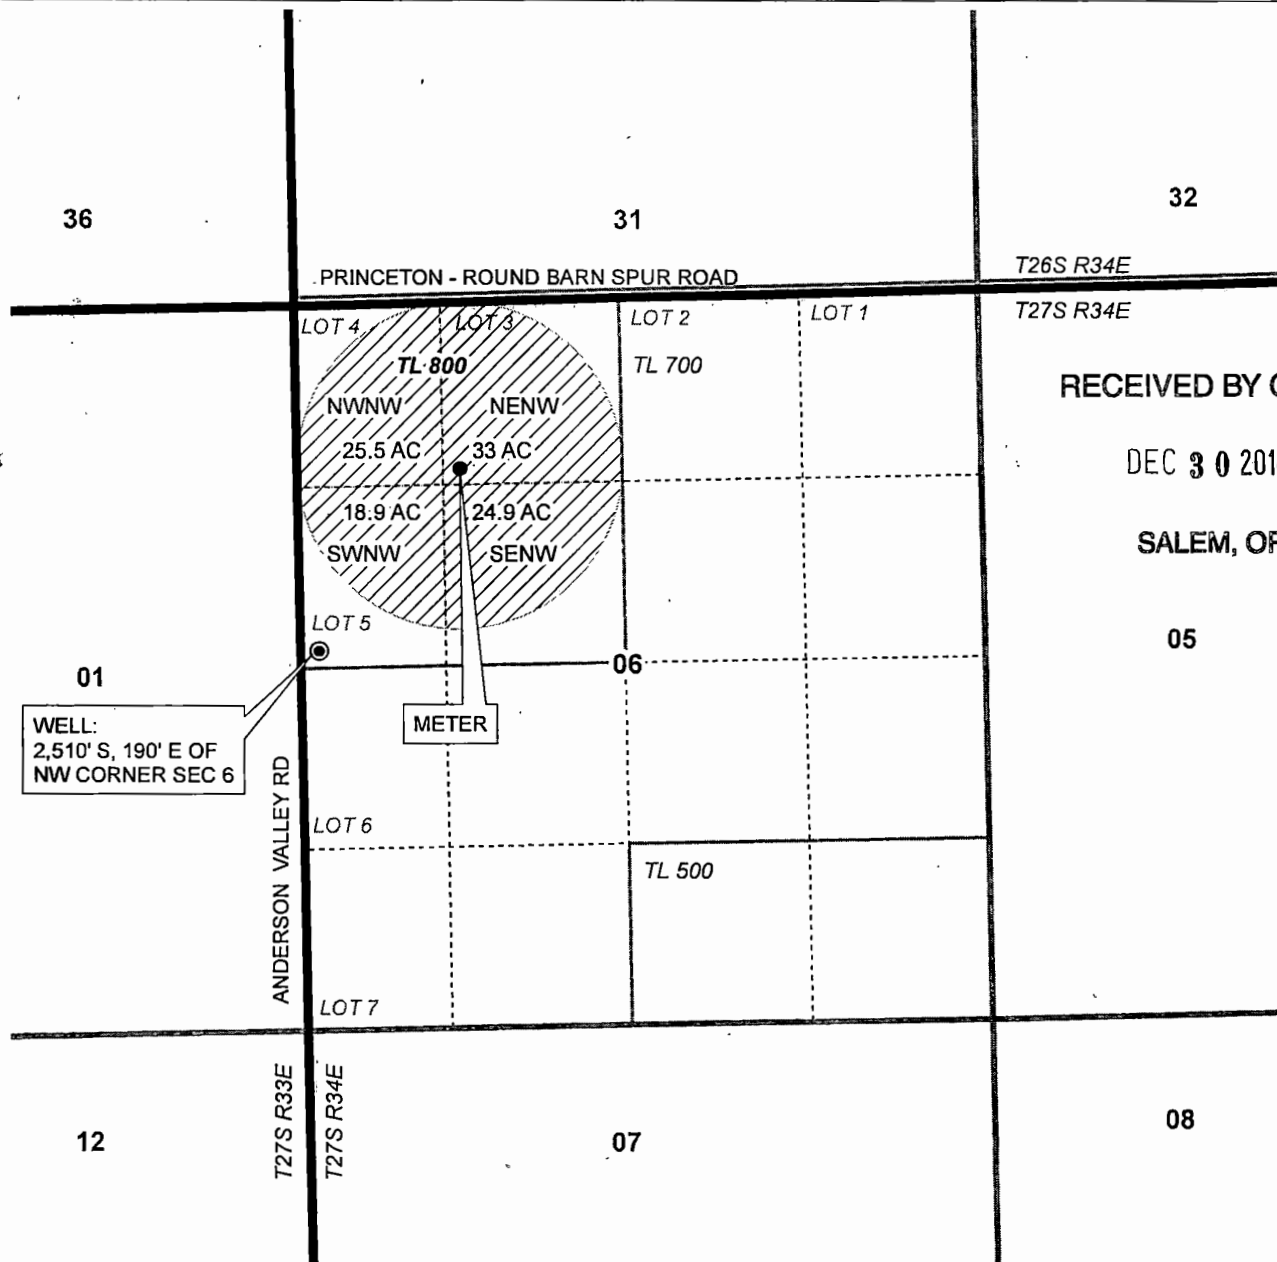


RECEIVED BY OWRD


DEC 30 2014

SALEM, OR

05

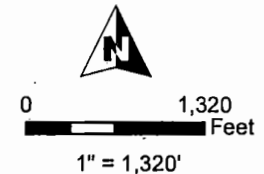

- POU Irrigation
- Township
- Section
- Quarter Quarter
- Taxlot
- Well

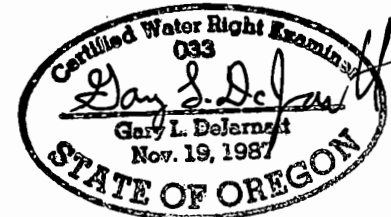

RENEWAL DATE 12/31/2015



CLAIM OF BENEFICIAL USE MAP
Martin

NOTE: THIS MAP IS NOT INTENDED TO
PROVIDE LEGAL DIMENSIONS OR LOCATIONS
OF PROPERTY OWNERSHIP LINES.

WATER RIGHT SERVICES, LLC

APPL G-17013

PERMIT G-16503

PROJECT #14089

DECEMBER 3, 2014

PO BOX 1830, BEND, OR 97709

CCB# 197121 www.oregonwater.us

541-389-2837 JOHNSHORT@USA.COM