


Claim of Beneficial Use Map
 SW & SE 1/4 of the NW 1/4 of Section 26
 Township 1S, Range 4E, W.M., Clackamas County
 Nursery Use 21.56 acres

Application #G-16184

Permit #G-15905

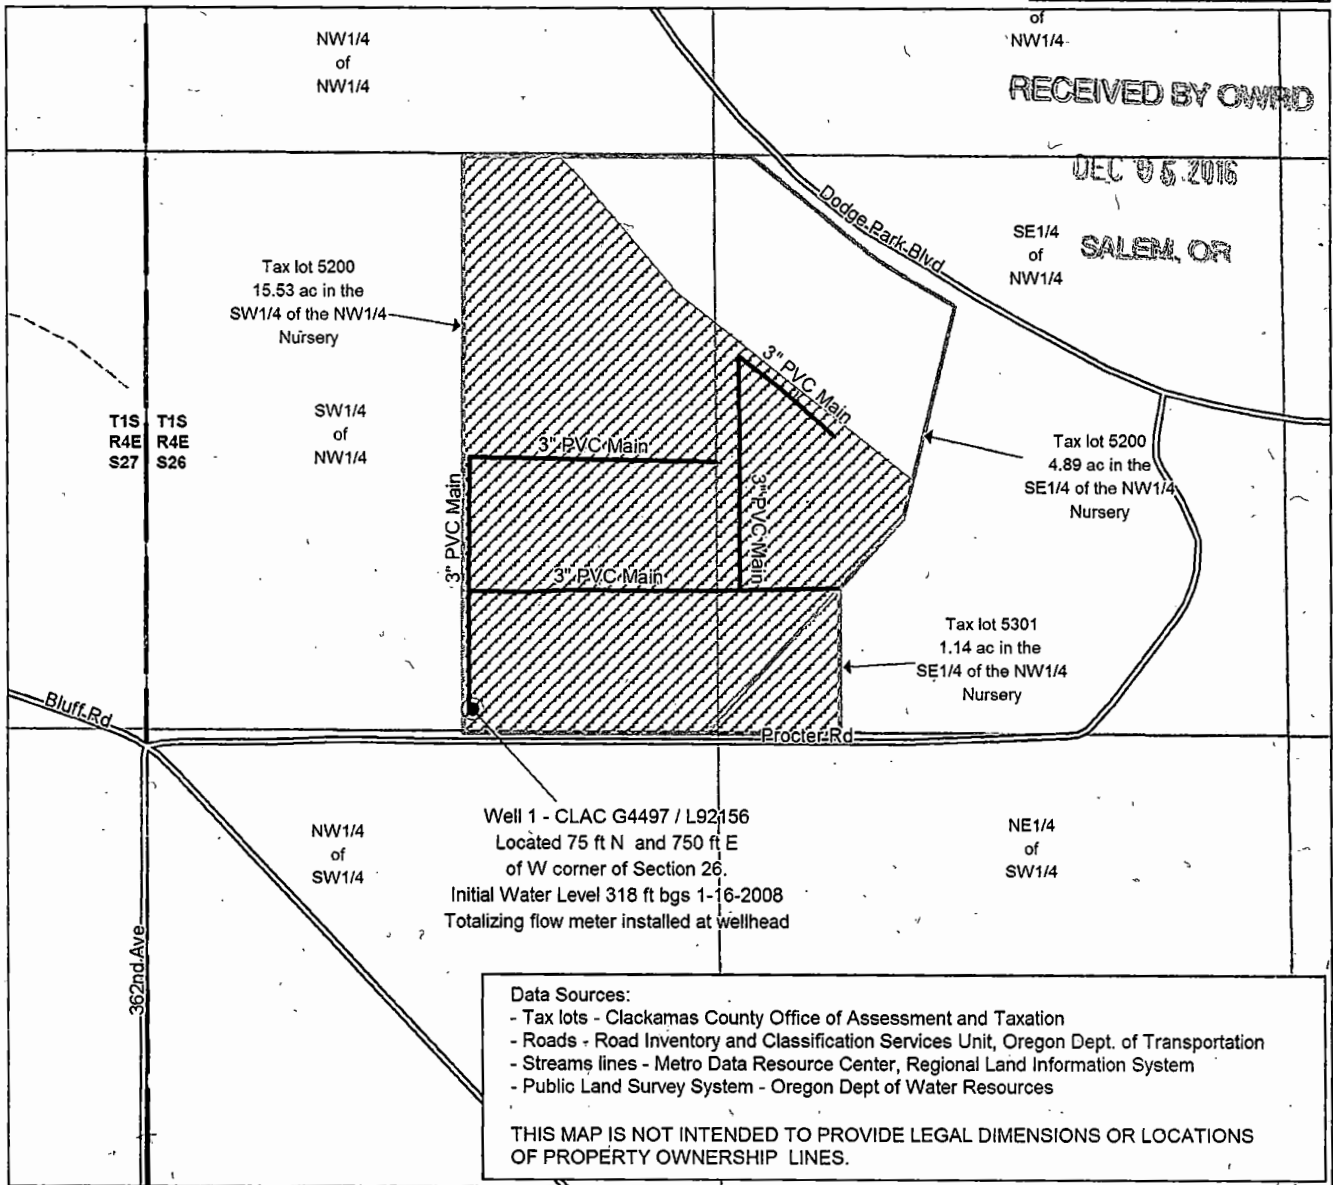


Data Sources:

- Tax lots - Clackamas County Office of Assessment and Taxation
- Roads - Road Inventory and Classification Services Unit, Oregon Dept. of Transportation
- Streams lines - Metro Data Resource Center, Regional Land Information System
- Public Land Survey System - Oregon Dept of Water Resources

THIS MAP IS NOT INTENDED TO PROVIDE LEGAL DIMENSIONS OR LOCATIONS OF PROPERTY OWNERSHIP LINES.

Legend

- | | | | |
|--|--------------------------|--|---------------------|
| | Tax lot boundary | | Irrigation pipeline |
| | Nursery irrigation areas | | Public Roads |
| | PLS quarter-quarter | | Streams |
| | PLS section boundary | | Irrigation Well |

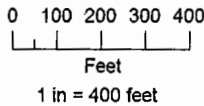

EXPIRATION DATE **12-31-2016**

CWM-H2O
Complete Water Management



503.799.0304 | www.waterenergyconsult.com

Bear Creek Farm, Inc.
37703 SE Bear Creek Lane
Boring, Oregon 97080

Draft: 04 June 2016
 Rev: 25 July 2016
 Final:
 Project 1514001 Page 1/1