


T24S, R32E

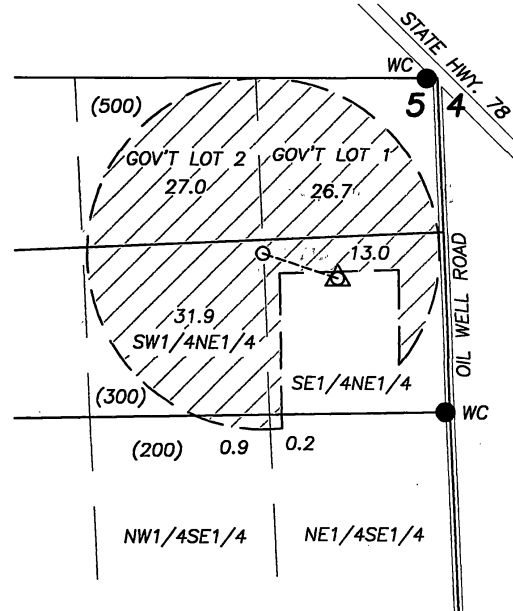

SCALE: 1" = 1320'



WELL IS 1470 FT. SOUTH AND 730 FT. WEST FROM THE TRUE POSITION OF THE NE COR. SEC. 5, T.24S., R.32E.

△ POA — WELL & FLOWMETER

○ CENTER PIVOT

----- BURIED PIPELINE

● FOUND RECORD SURVEY MONUMENT

▨ CURRENT PLACE OF USE

() TAX LOT

FINAL PROOF SURVEY

UNDER PERMIT NO. G-16255

APPLICATION NO. G-16754


IN NAME OF

KENT SCOTT

BY

ROBERT D. BAGETT
217 N. CANYON BLVD.
JOHN DAY, OREGON
(541) 575-1251

DATE SURVEYED: JULY 10, 2013

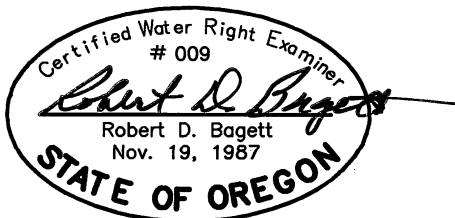

NOTE: THE PREPARATION OF THIS MAP WAS FOR THE PURPOSE OF IDENTIFYING THE LOCATION OF THE PROPOSED WATER RIGHT AND HAS NO INTENT TO PROVIDE DIMENSIONS OR LOCATION OF PROPERTY OWNERSHIP LINES.

RECEIVED BY OWRD

AUG 23 2013

SALEM, OR