

EXPLANATION

Irrigated Acres by Diversion, Primary and Supplemental

- POD 3
- POD 4
- POD 5
- POD 8
- POD 9
- POD 10
- POD 11

POD-1 Approximate Location of Existing Points of Diversion

Overall Map - Claim of Beneficial Use, T-10233
 River Run Ranch
 Crook County, Oregon

FIGURE 2

PROJECT NO. 1018-102

DATE: Oct 2010



NEWTON CONSULTANTS INC.
 Earth, Water and Rock Specialists
 Ph: 541 504-9960 Fax: 541 504-9961


DRAWN BY: S. Schenck

DESIGNED BY: K. Turner

Overview Map for Claim of Beneficial Use, T-10233
T14S, R14E, Sections 22, 23 & 24

NOTES

1. This map was prepared for the purpose of identifying the location of water rights only and is not intended to provide legal dimensions or locations of property ownership lines.
2. Water volume equivalent to the duty from 29.0 acres for pond maintenance.
3. This map shows entire area for certification. See additional maps for detail.

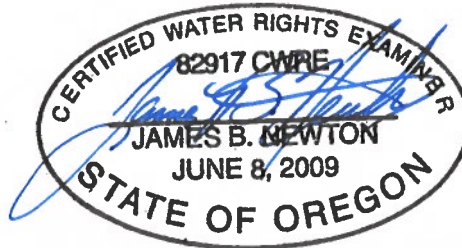


EXPIRES: 12-31-2010
 RENEWS: 12-31-2010

RECEIVED

OCT 04 2010

WATER RESOURCES DEPT
 SALEM, OREGON



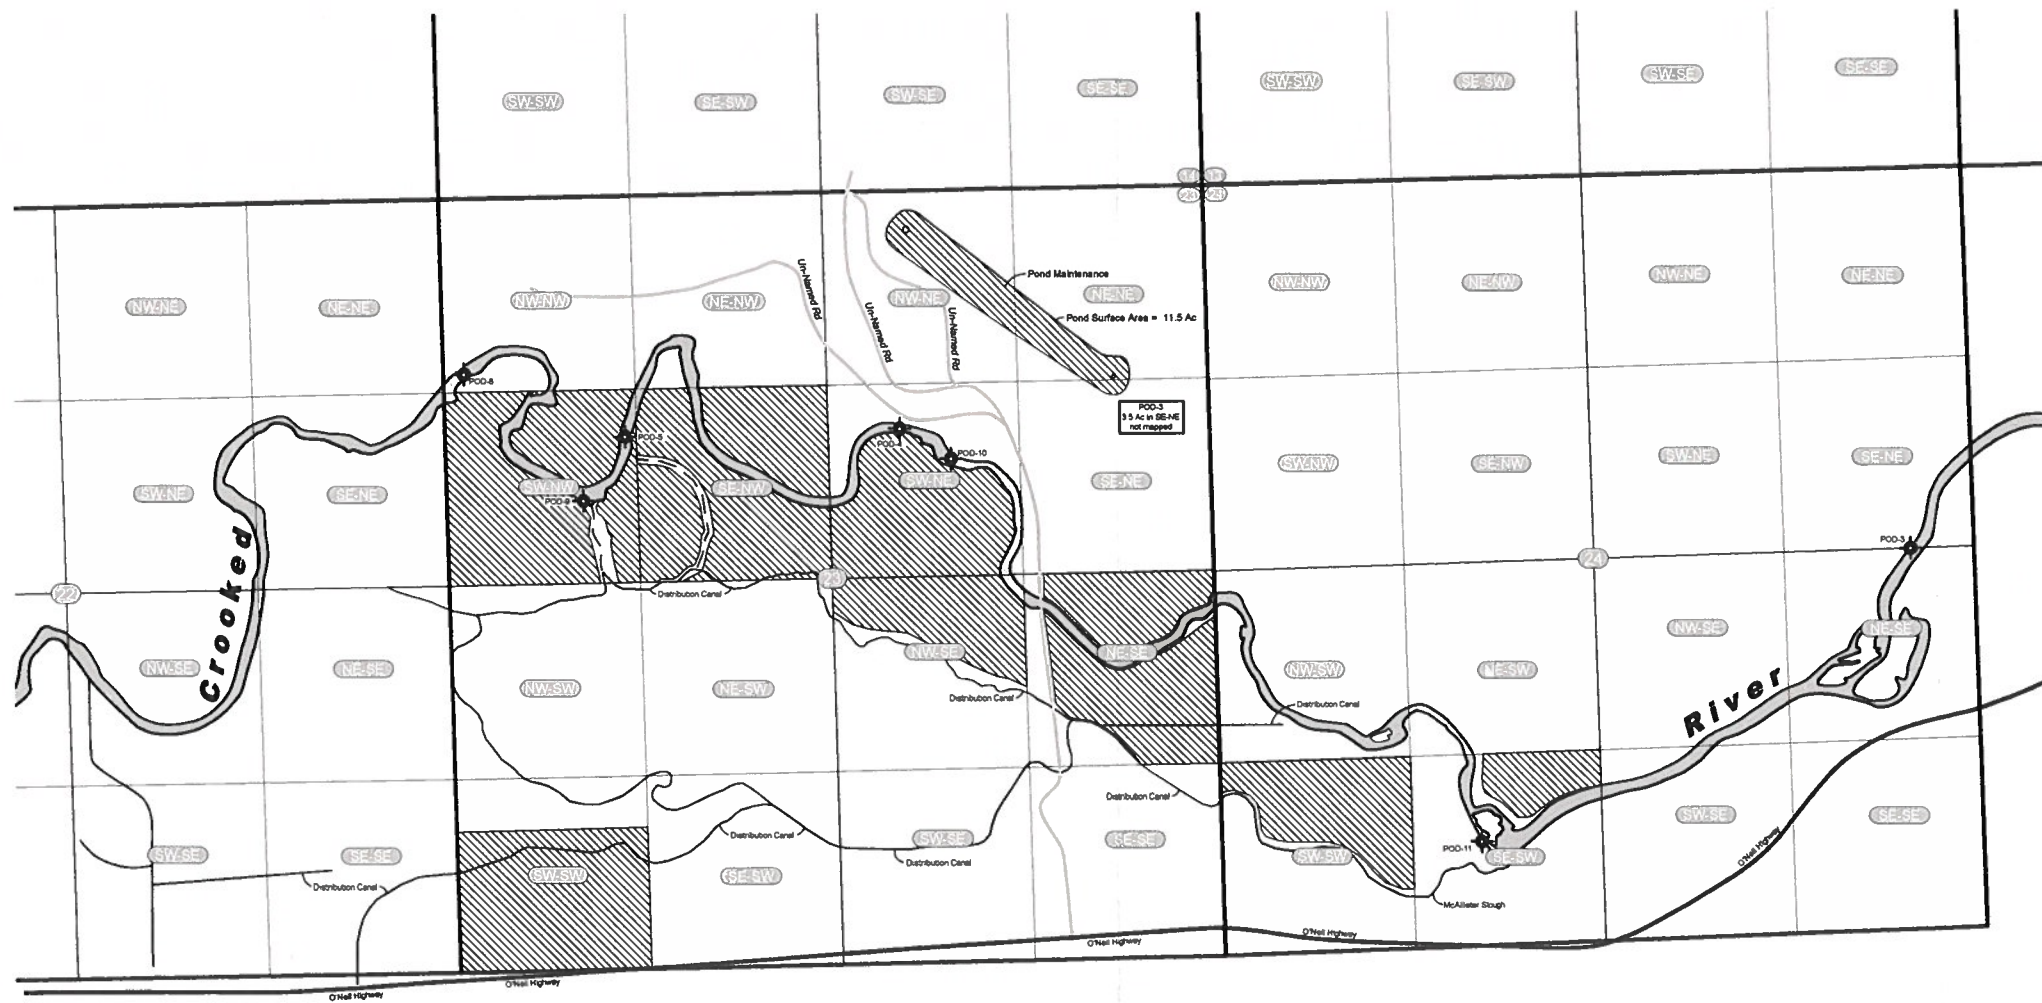

EXPLANATION
 Primary Acres
 Approximate Location of Existing Points of Diversion


Overall Map - Primary Irrigation Acres, T-10233
 River Run Ranch
 Crook County, Oregon

DESIGNED BY: K. Turner
 DRAWN BY: S. Schenck
 DATE: Oct 2010
 PROJECT NO. 1018-102
 FIGURE 3

Overall Map Primary Irrigation Acres, T-10233
T14S, R14E, Sections 22, 23 & 24

NOTES

1. This map was prepared for the purpose of identifying the location of water rights only and is not intended to provide legal dimensions or locations of property ownership lines.


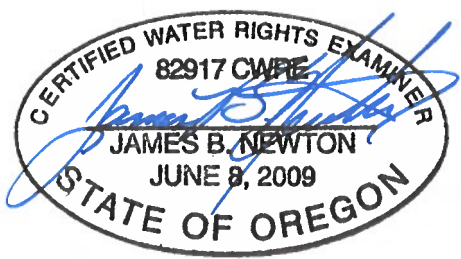


EXPIRES:
 RENEWS: 12-31-2010

RECEIVED

OCT 04 2010

WATER RESOURCES DEPT
 SALEM, OREGON

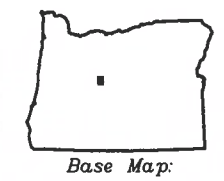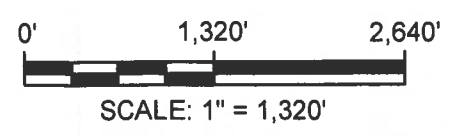

Base Map:



NEWTON
CONSULTANTS INC.
 Earth, Water and Rock Specialists
 Ph: 541 504-9980
 Fax: 541 504-9961




EXPLANATION
 [Hatched Box] Supplemental Acres
 [Symbol] Approximate Location of Existing Points of Diversion

**Overall Map Supplemental Irrigation Acres, T-10233
 T14S, R14E, Sections 22, 23 & 24**

NOTES

1. This map was prepared for the purpose of identifying the location of water rights only and is not intended to provide legal dimensions or locations of property ownership lines.

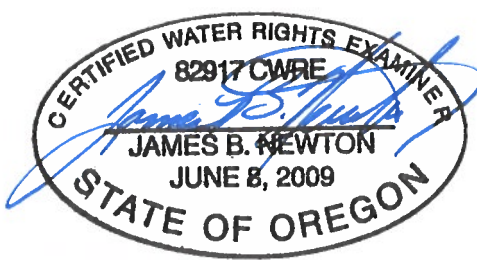


EXPIRES:
 RENEWS: *12-31-2010*

RECEIVED

OCT 04 2010

WATER RESOURCES DEPT
 SALEM, OREGON

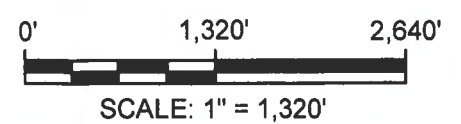


Base Map:

Overall Map - Supplemental Irrigation Acres, T-10233
 River Run Ranch
 Crook County, Oregon

NEWTON CONSULTANTS INC.
 Earth, Water and Rock Specialists
 Ph: 541 504-9960
 Fax: 541 504-9961

DESIGNED BY:	K. Turner
DRAWN BY:	S. Schenck
DATE:	Oct 2010
PROJECT NO.:	1018-102
FIGURE	4

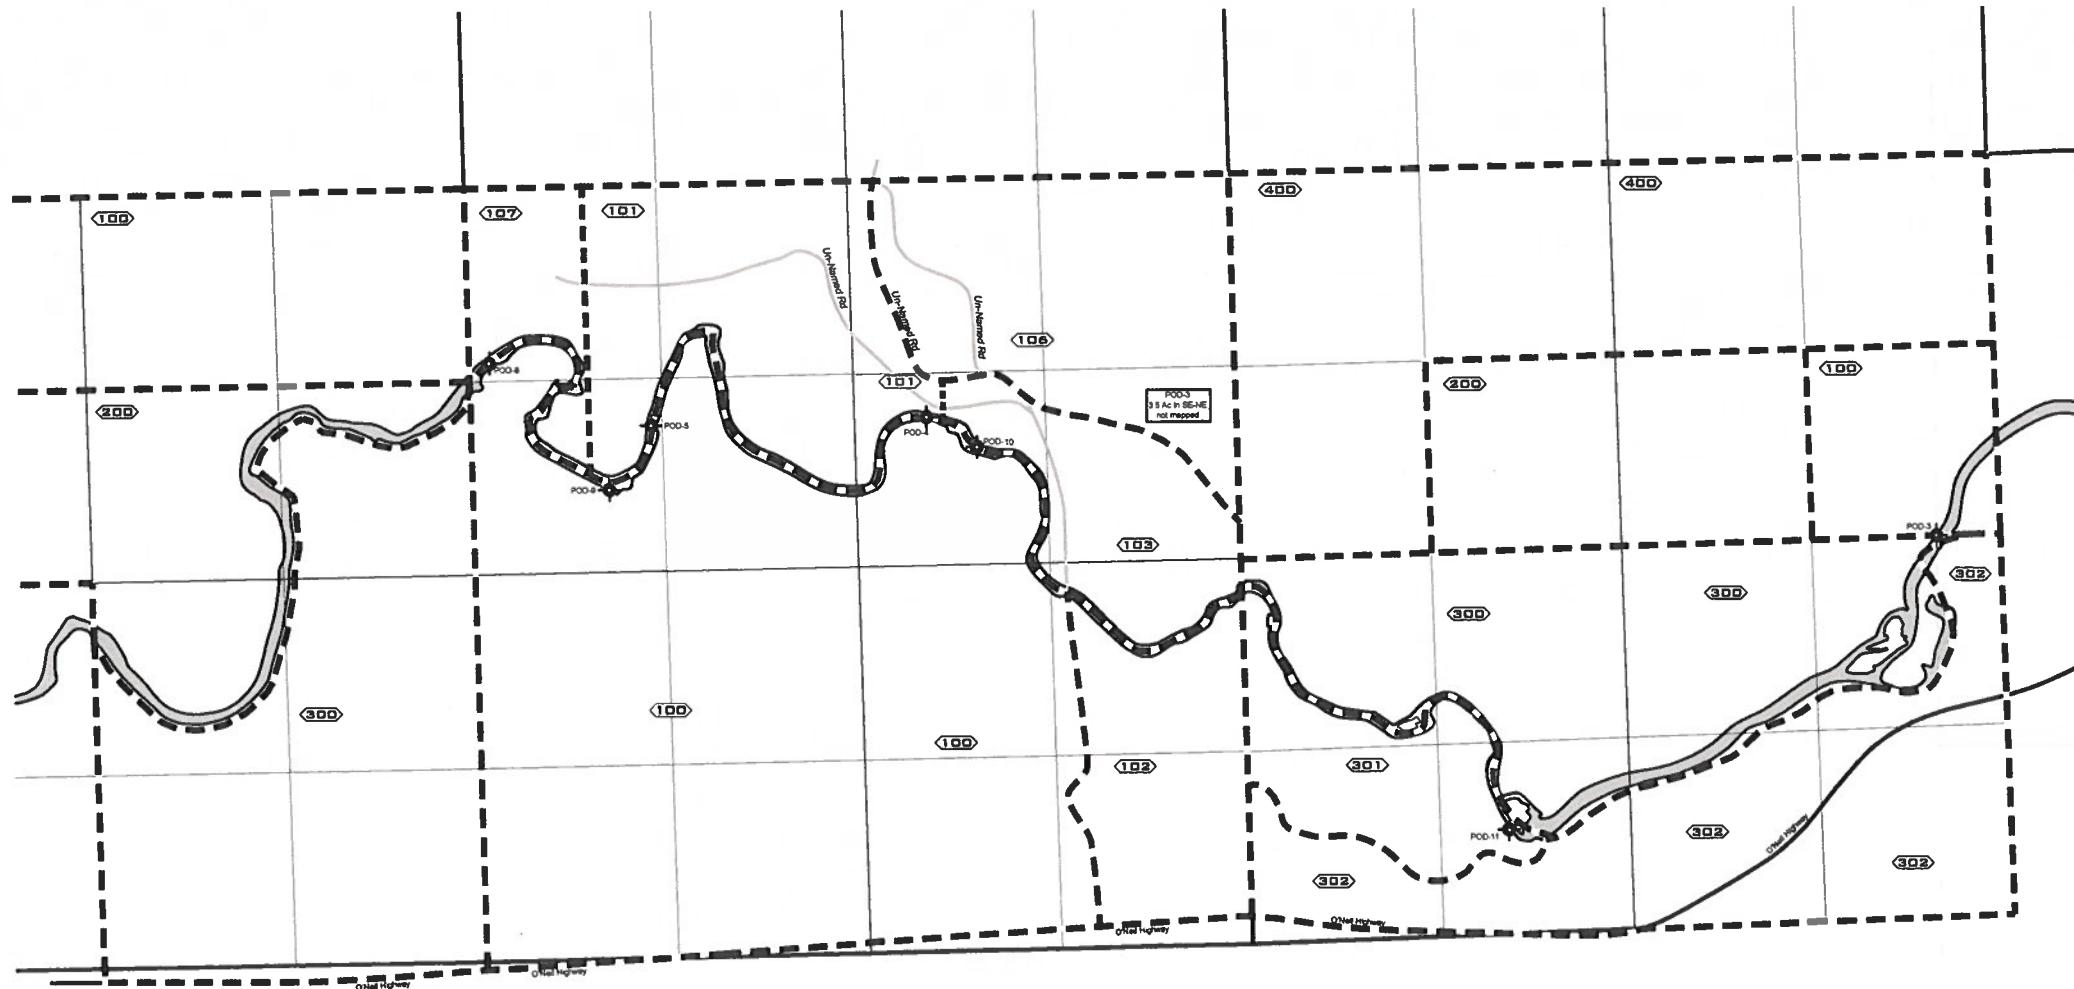

EXPLANATION
 POD-01 Approximate Location of Existing Points of Diversion
 Tax Lot Boundary
 Tax Lot ID Number

Overall Map - Tax Lot Map, T-10233
 River Run Ranch
 Crook County, Oregon

DESIGNED BY: **K. Turner** DRAWN BY: **S. Schenck** DATE: **Oct 2010** PROJECT NO. **1018-102** FIGURE **5**

Overall Map Tax Lot Map, T-10233
T14S, R14E, Sections 22, 23 & 24

NOTES

1. This map was prepared for the purpose of identifying the location of water rights only and is not intended to provide legal dimensions or locations of property ownership lines.
2. Information based on tax lot maps from Crook County revised 6/22/2006.

CERTIFIED WATER RIGHTS EXAMINER
 82917 CWBE
James B. Newton
 JAMES B. NEWTON
 JUNE 8, 2009
 STATE OF OREGON
 EXPIRES:
 RENEWS: *12-31-2010*


RECEIVED
 OCT 04 2010
 WATER RESOURCES DEPT
 SALEM, OREGON

0' 1,320' 2,640'
 SCALE: 1" = 1,320'

Base Map:

NEWTON
 CONSULTANTS INC.
 Earth, Water and Rock Specialists
 Ph: 541 504-9960 Fax: 541 504-9961

0570
1 of 5

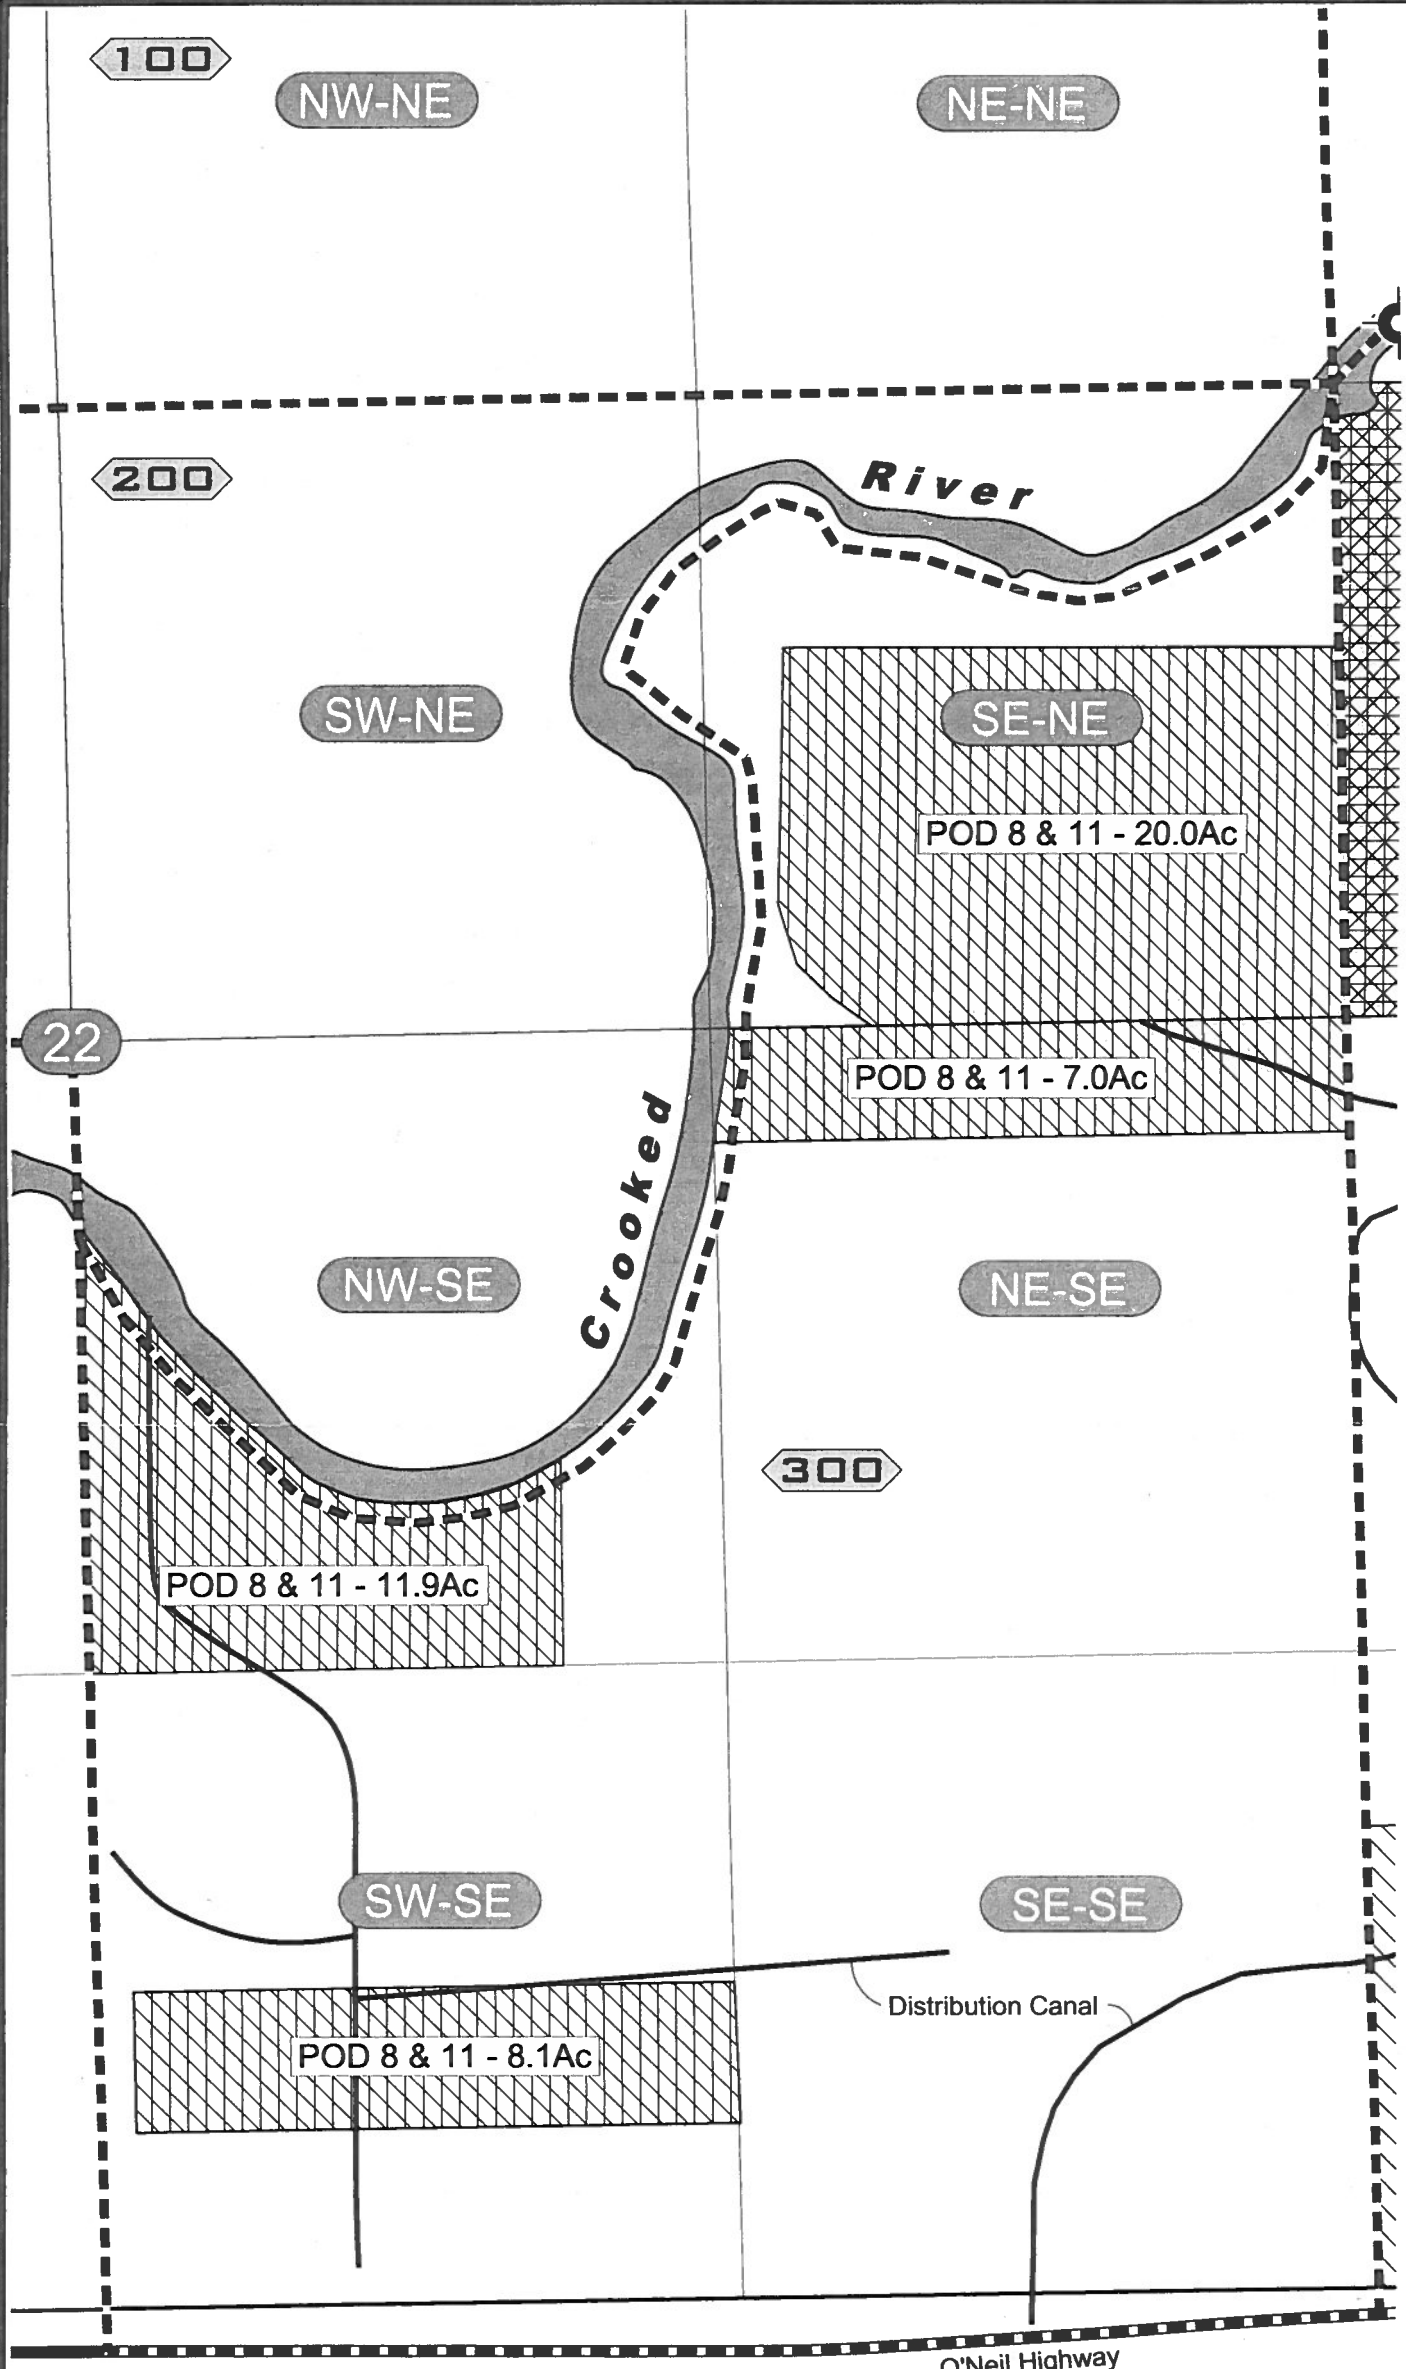


EXPLANATION

Irrigated Acres by Diversion, Primary and Supplemental

	POD 3
	POD 4
	POD 5
	POD 8
	POD 9
	POD 10
	POD 11
	Tax Lot Boundary
	Tax Lot ID Number

CERTIFIED WATER RIGHTS EXAMINER
82917 CWRE
James B. Newton
JAMES B. NEWTON
JUNE 8, 2009
STATE OF OREGON


EXPIRES: 12-31-2010
RENEWS: 12-31-2010

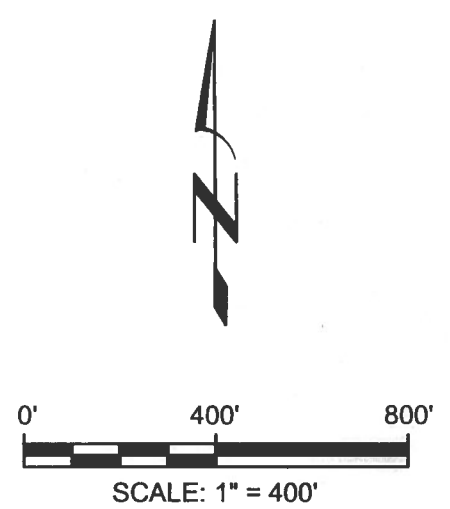

T14S, R14E, Section 22 - Supplemental Rights

NOTES
THIS MAP WAS PREPARED FOR THE PURPOSE OF IDENTIFYING THE LOCATION OF WATER RIGHTS ONLY AND IS NOT INTENDED TO PROVIDE LEGAL DIMENSIONS OR LOCATIONS OF PROPERTY OWNERSHIP LINES.

RECEIVED
OCT 04 2010
WATER RIGHTS DEPT
SOUTH OREGON

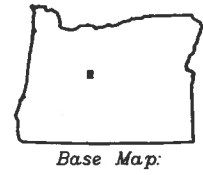

COBU MAP 0540


NEWTON CONSULTANTS INC.
Earth, Water and Rock Specialists
Ph: 541 504-9960 Fax: 541 504-9961

Claim of Beneficial Use, T-10233, Section 22 (E $\frac{1}{2}$)
River Run Ranch
Crook County, Oregon

DESIGNED BY: K.Tumer	DRAWN BY: S.Schenck	DATE: Oct 2010	PROJECT NO. 1018-102	FIGURE 6
-------------------------	------------------------	-------------------	-------------------------	-------------

0540
2 of 5

C:\1000\1018\1021\Conf\Water\1018102\F2_C000_A 14:55 09/30/2010 SS

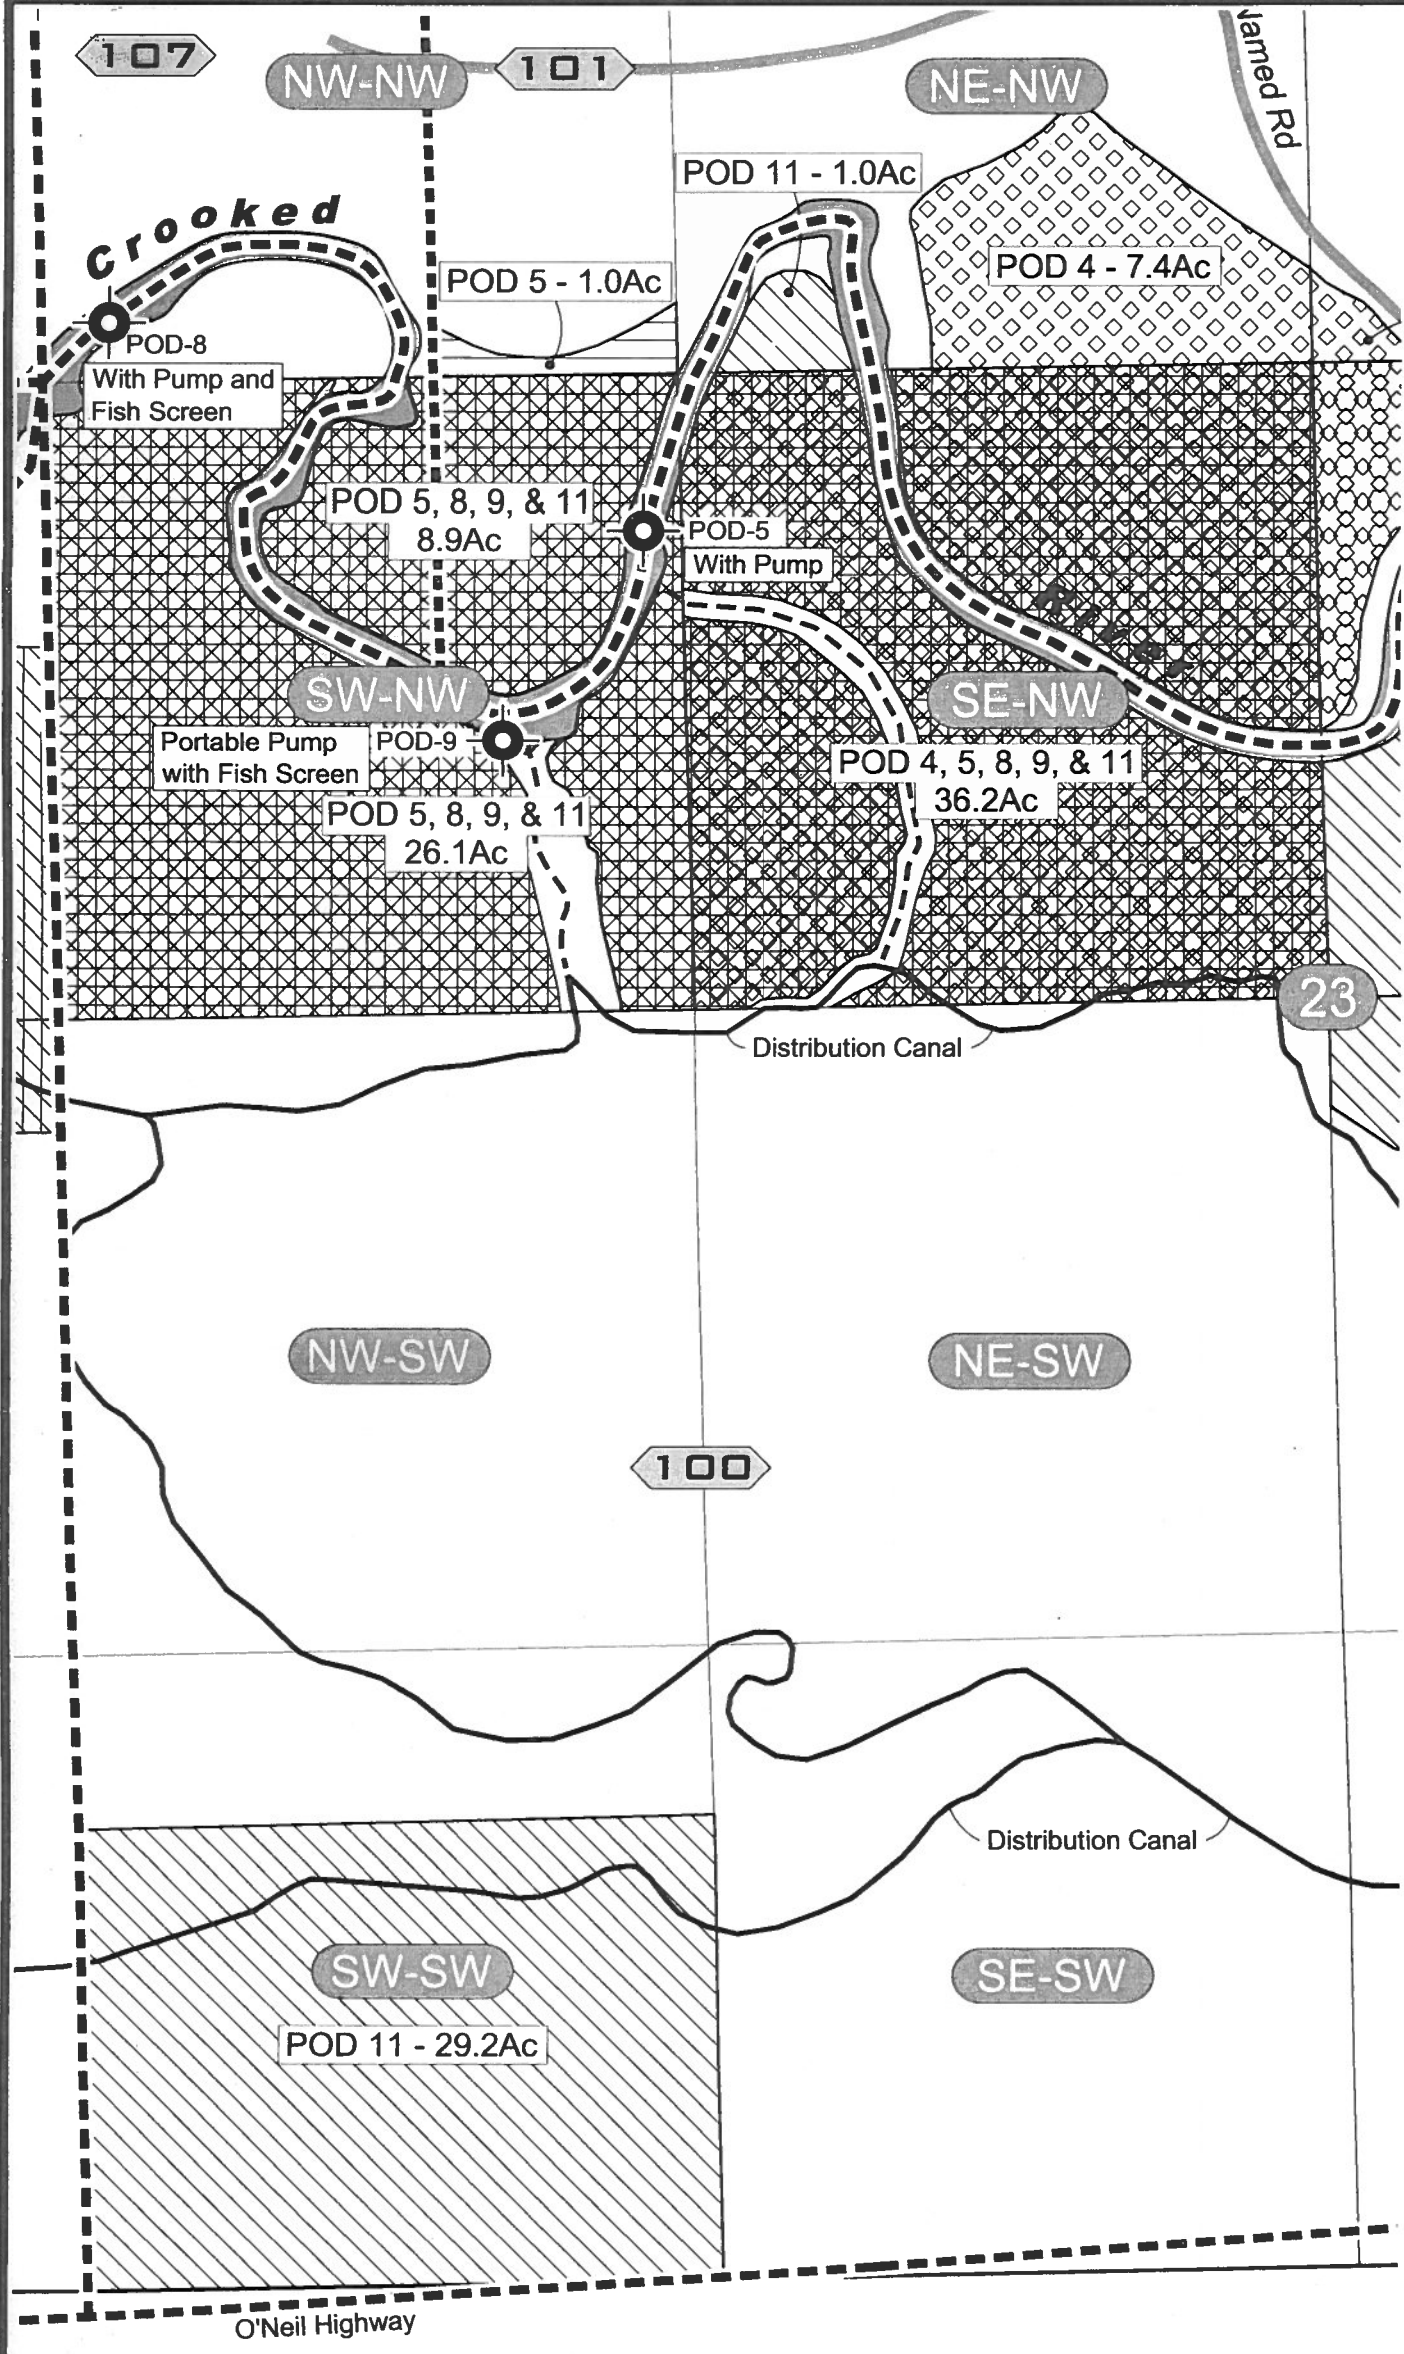

EXPLANATION


Irrigated Acres by Diversion, Primary and Supplemental

	POD 3
	POD 4
	POD 5
	POD 8
	POD 9
	POD 10
	POD 11


Tax Lot Boundary

Tax Lot ID Number

- ### POD Location
- POD-5** - Existing Diversion 1,000 ft North and 1,400 ft West of Center 1/4 Corner of Section 23.
 - POD-8** - Existing Diversion 1,450 ft North and 2,500 ft West of the Center of Section 23.
 - POD-9** - Existing Diversion 565 ft North and 1,700 ft West of the Center of Section 23.

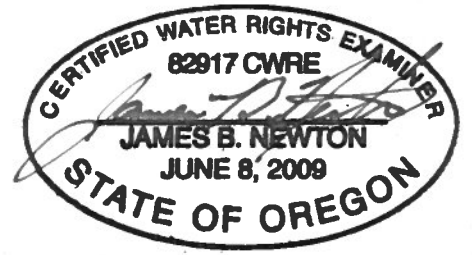

EXPIRES: 12-31-2010
RENEWS:

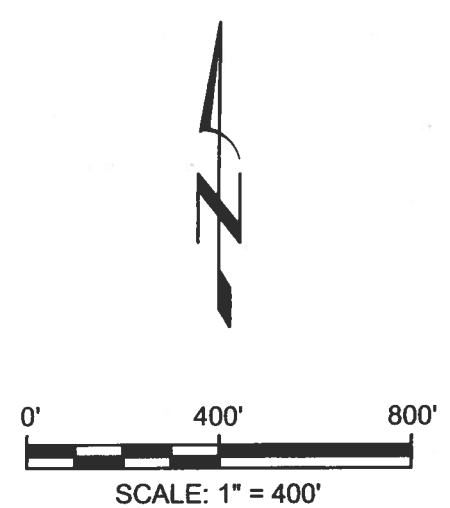


T14S, R14E, Section 23 - Primary & Supplemental Rights

NOTES

THIS MAP WAS PREPARED FOR THE PURPOSE OF IDENTIFYING THE LOCATION OF WATER RIGHTS ONLY AND IS NOT INTENDED TO PROVIDE LEGAL DIMENSIONS OR LOCATIONS OF PROPERTY OWNERSHIP LINES.

RECEIVED
OCT 04 2010
WATER RESOURCES DEPT
SALEM, OREGON

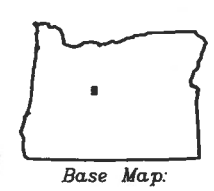

NEWTON CONSULTANTS INC.
Earth, Water and Rock Specialists
Ph: 541 504-9960 Fax: 541 504-9961

Claim of Beneficial Use, T-10233, Section 23 (W¹/₂)
River Run Ranch
Crook County, Oregon

DESIGNED BY: K. Turner	DRAWN BY: S. Schenck	DATE: Oct 2010	PROJECT NO. 1018-102	FIGURE 7
---------------------------	-------------------------	-------------------	-------------------------	-------------



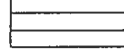

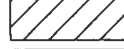
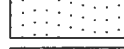

COBUC MAP 0542

0540
30f5

C:\1000\1018\102\Cad\Water\1018\02_F2_COBU_A 14:55 09/30/2010 SS



EXPLANATION

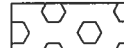
Irrigated Acres by Diversion, Primary and Supplemental

-  POD 3
-  POD 4
-  POD 5
-  POD 8
-  POD 9
-  POD 10
-  POD 11


-  Tax Lot Boundary
-  Tax Lot ID Number

POD Location

-  **POD-4** - Existing Diversion
1,020 ft North and 500 ft East of
Center 1/4 Corner of Section 23.
-  **POD-10** - Existing Diversion
805 ft North and 845 ft East
of the Center of Section 23.

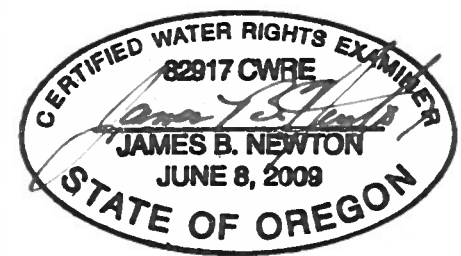


EXPIRES: 12-31-2010
RENEWS:

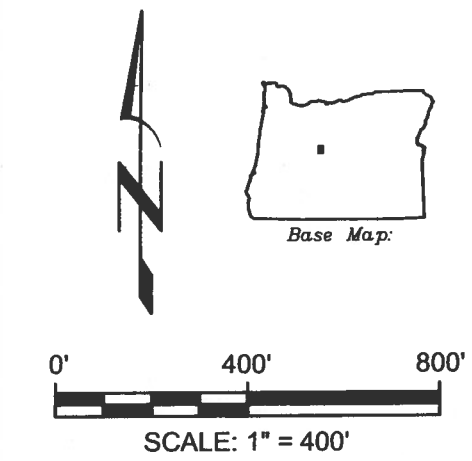

NOTES

1. This map was prepared for the purpose of identifying the location of water rights only and is not intended to provide legal dimensions or locations of property ownership lines.
2. Water volume equivalent to the duty from 29.0 acres for pond maintenance.

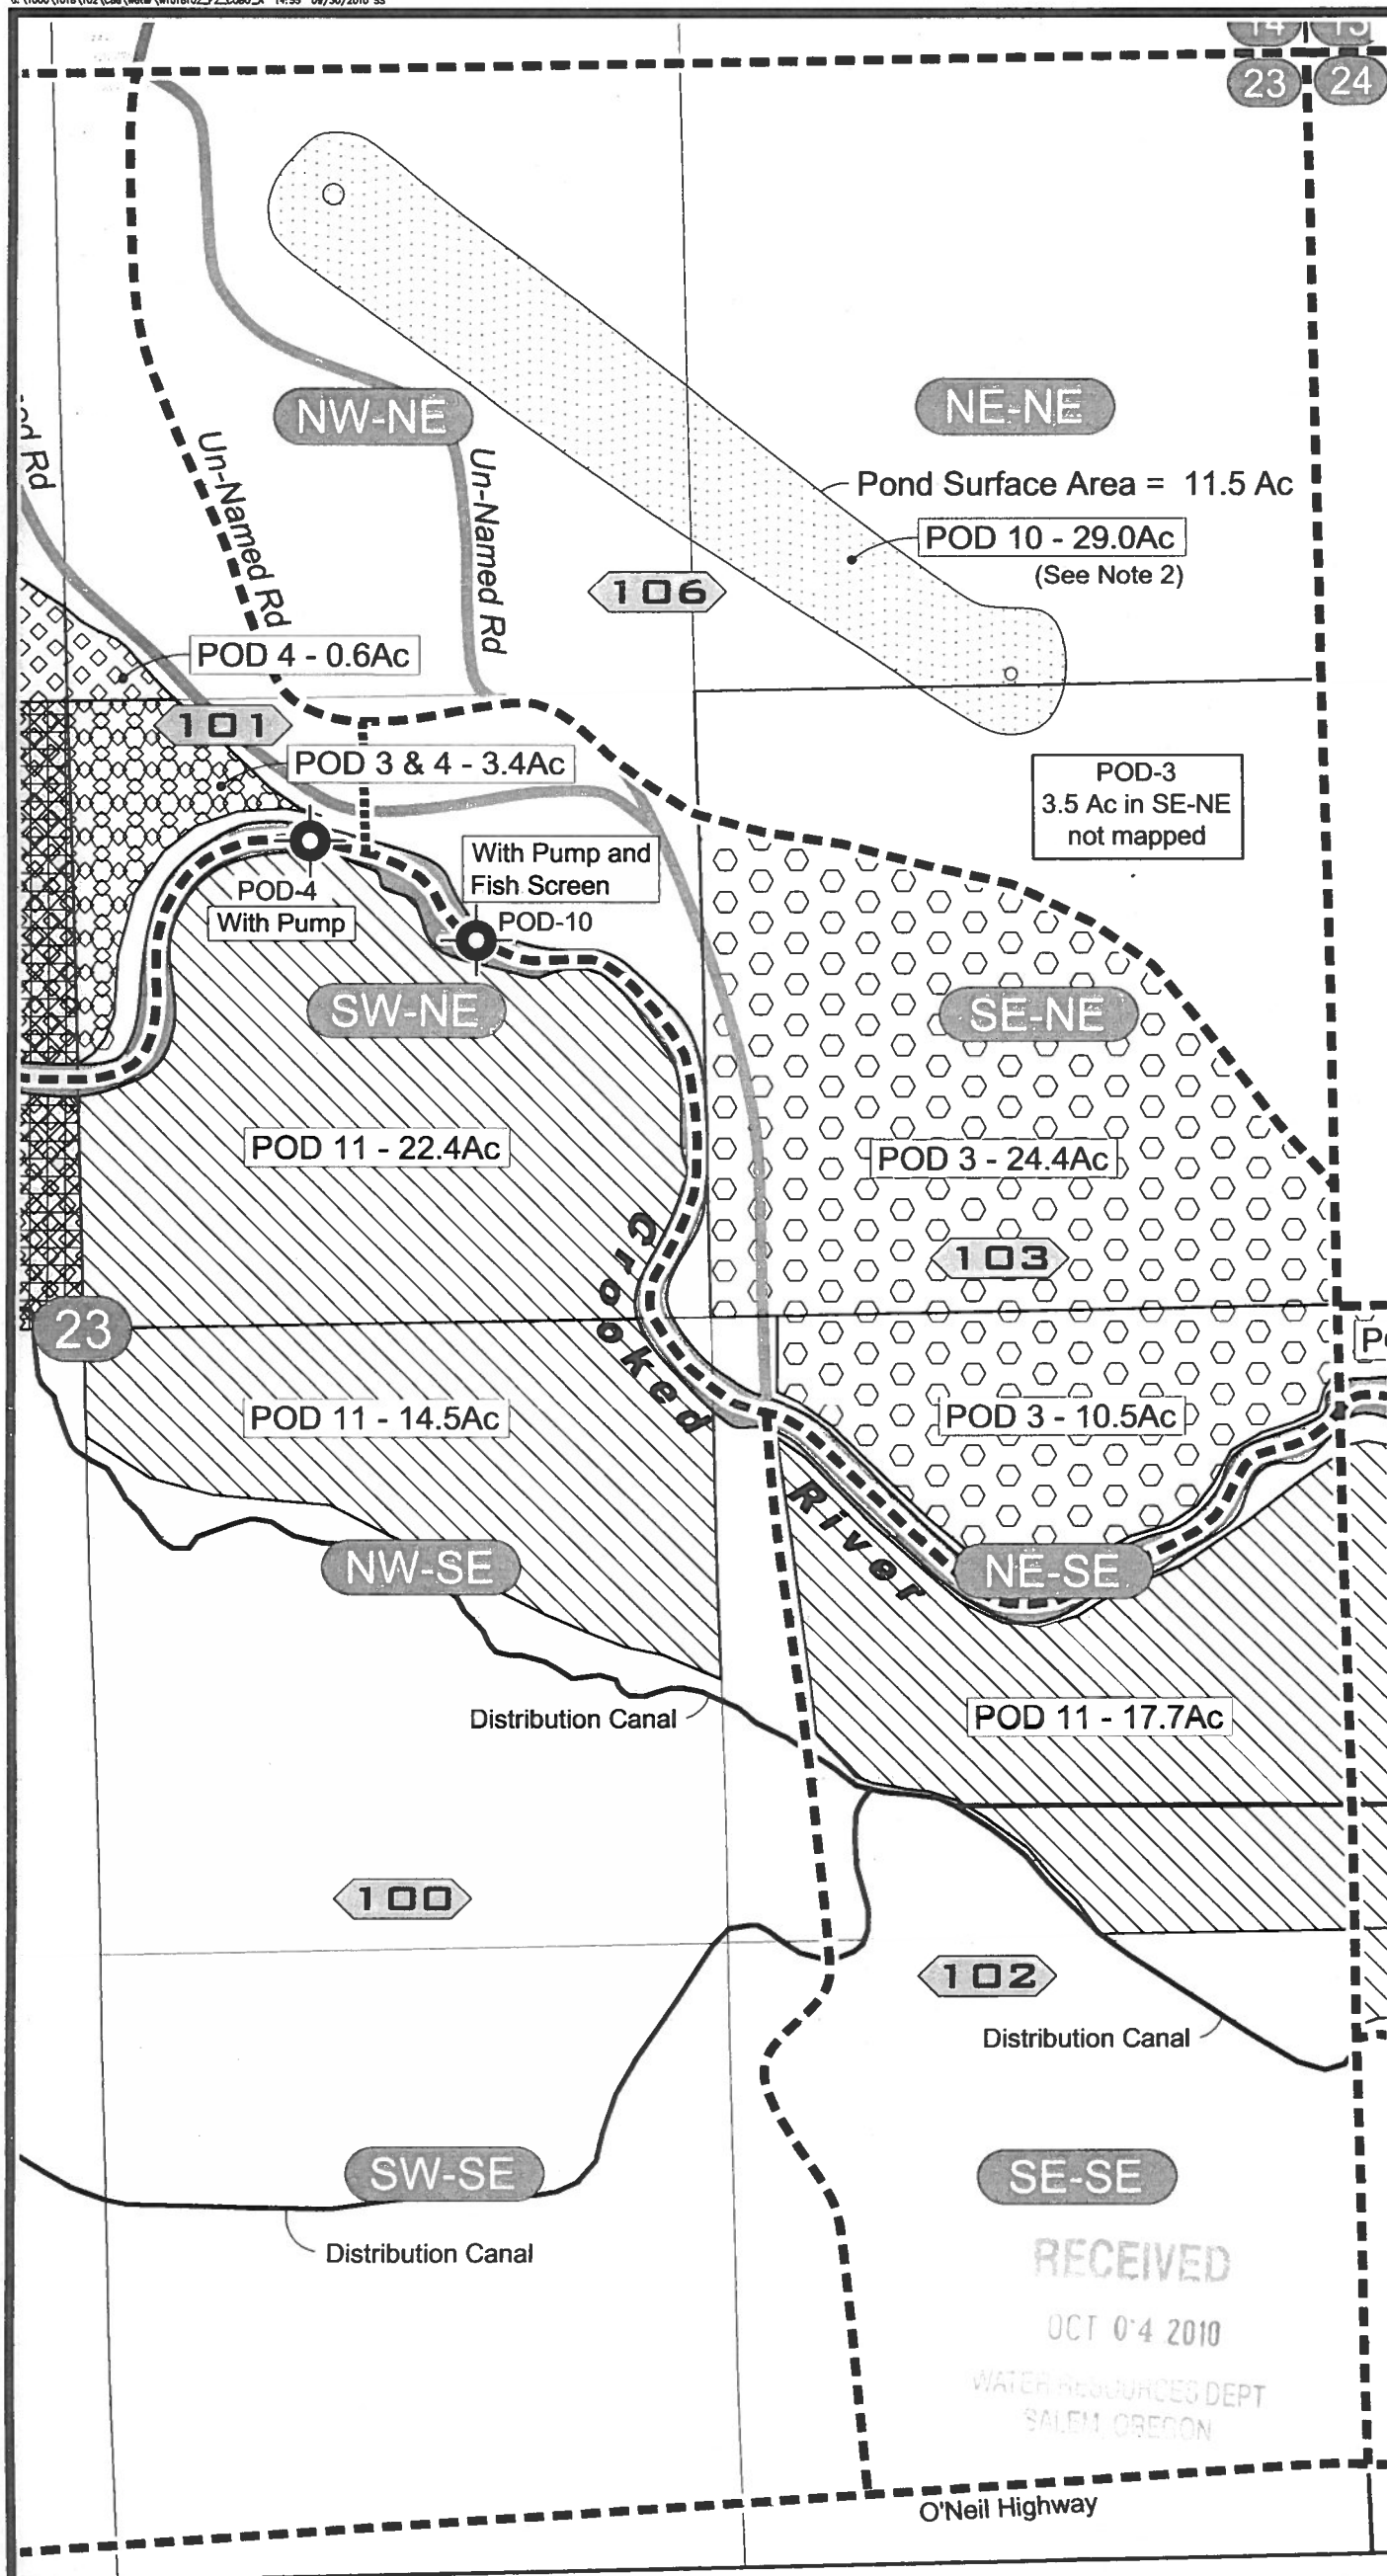

RECEIVED
OCT 04 2010
WATER RESOURCES DEPT
SALEM, OREGON

T14S, R14E, Section 23, Primary & Supplemental Rights

NEWTON CONSULTANTS INC.
Earth, Water and Rock Specialists
Ph: 541 504-9960 Fax: 541 504-9961


Claim of Beneficial Use, T-10233, Section 23 (E½)
River Run Ranch
Crook County, Oregon

DESIGNED BY: K.Turner	DRAWN BY: S.Schenck	DATE: Oct 2010	PROJECT NO. 1018-102	FIGURE 8
--------------------------	------------------------	-------------------	-------------------------	-------------

COBU MAP 0540

0540
4 of 5

C:\1000\1018\102\Conf\Water\1018102_F3_COBU_A 14:33 09/30/2010 SS

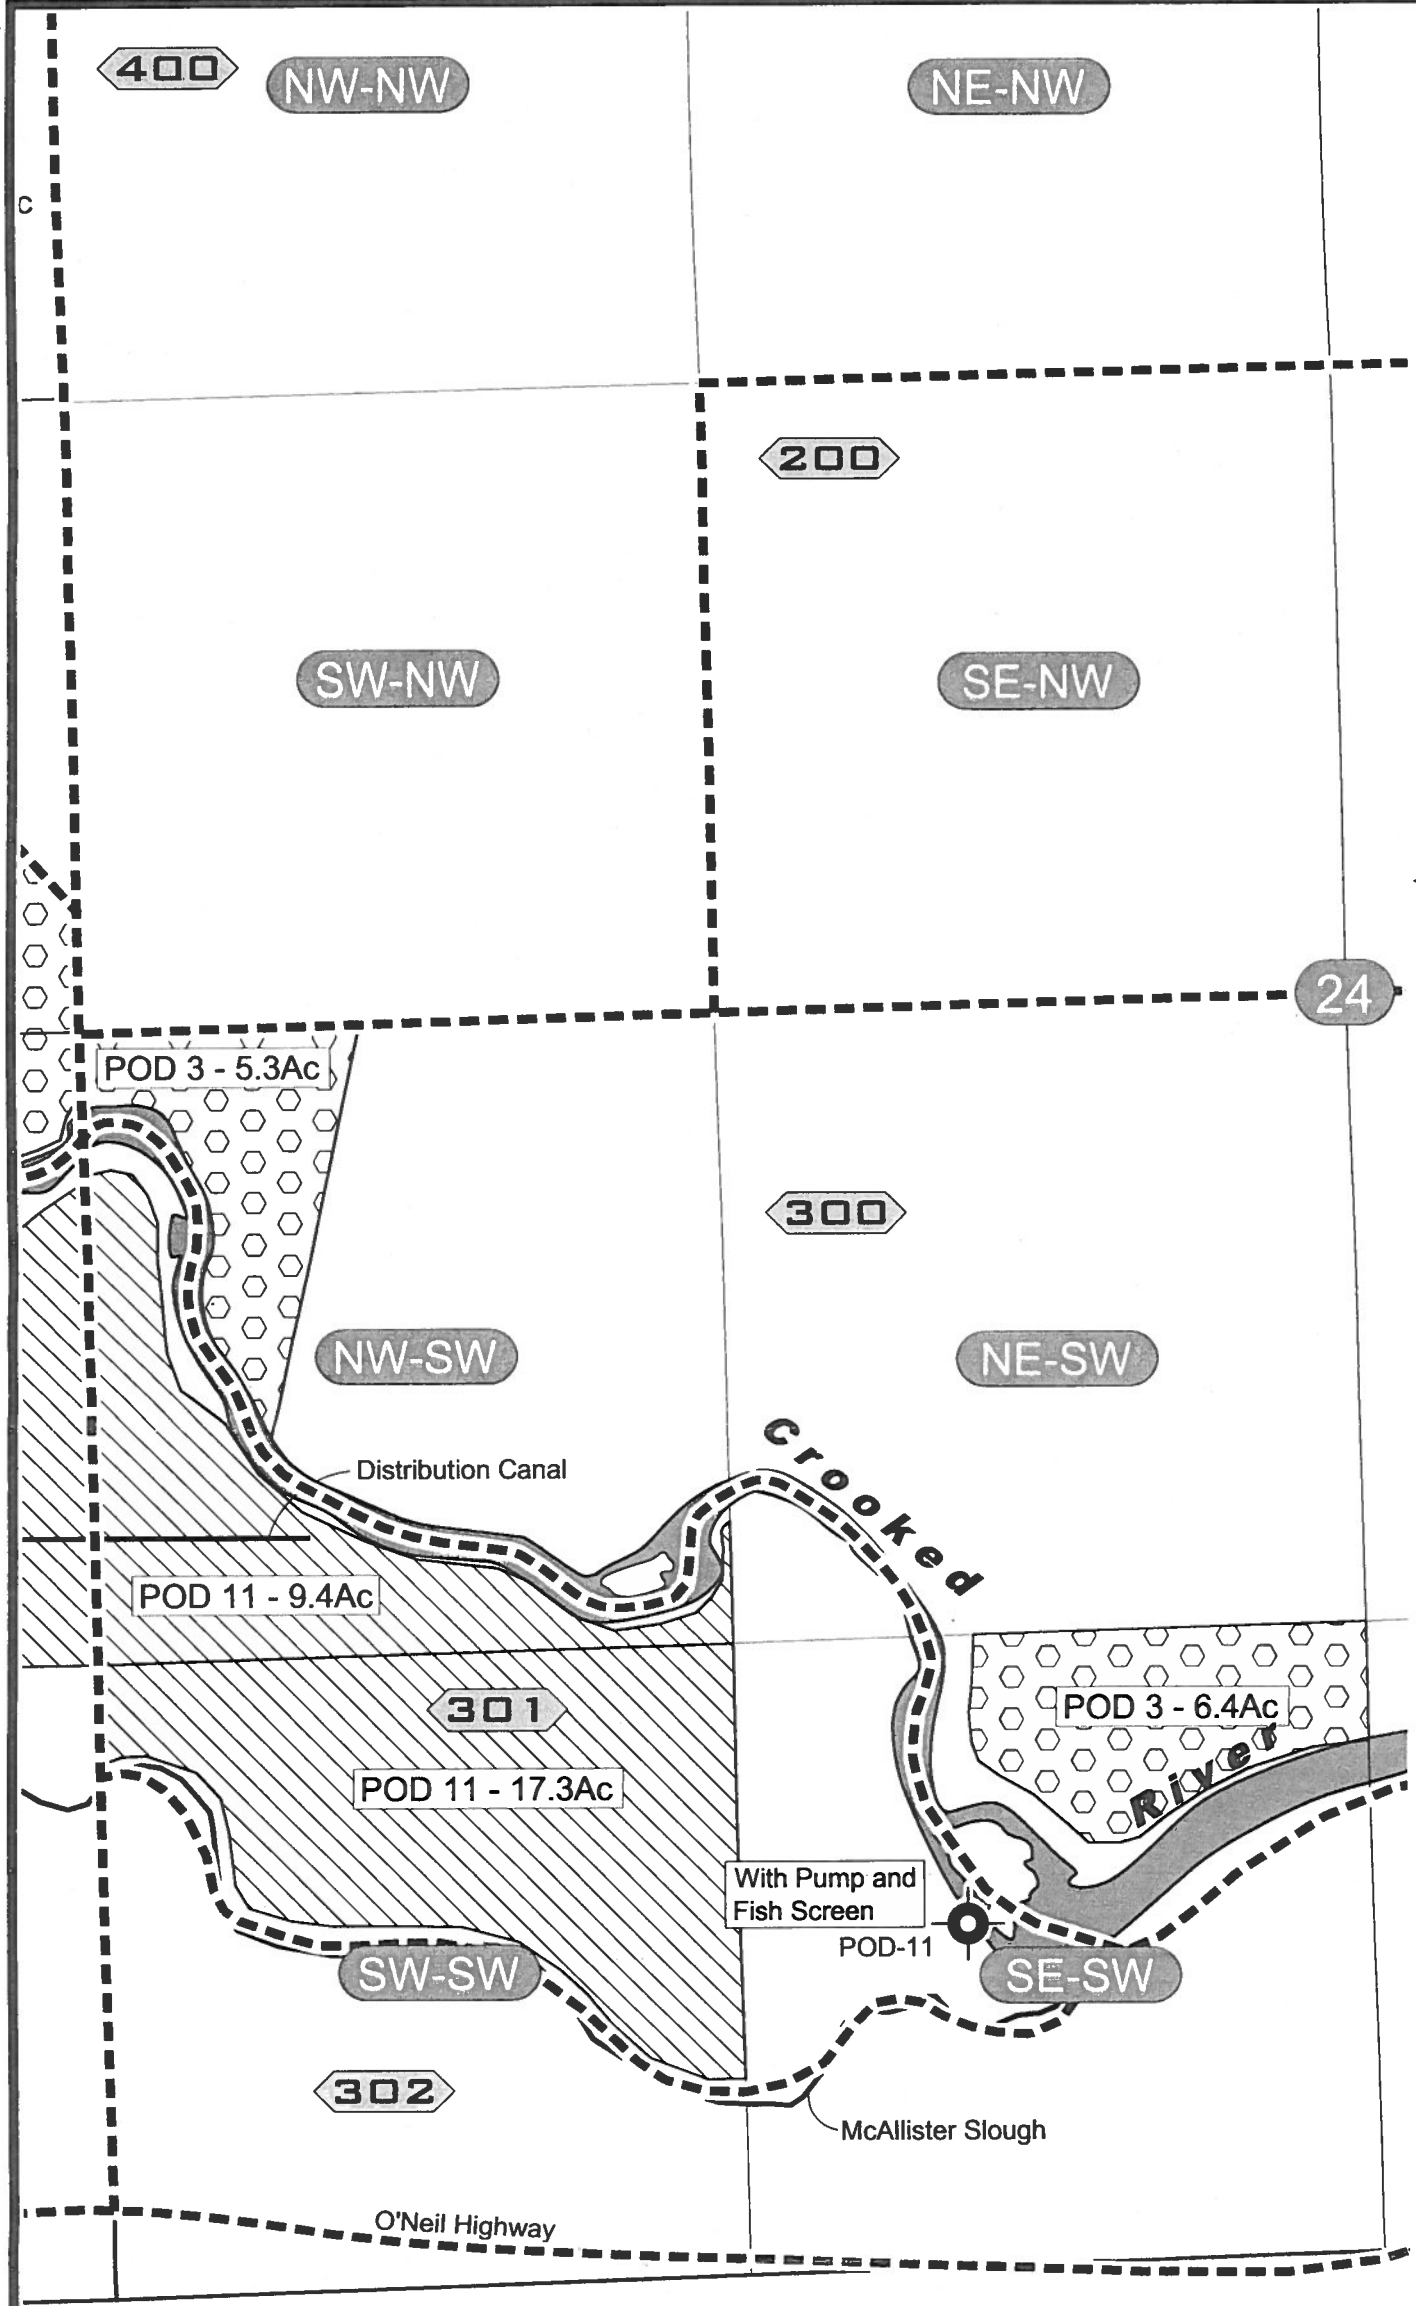

EXPLANATION

Irrigated Acres by Diversion, Primary and Supplemental


- POD 3
- POD 4
- POD 5
- POD 8
- POD 9
- POD 10
- POD 11

Tax Lot Boundary


Tax Lot ID Number

POD Location

POD-11 - Existing Diversion
1,915 ft South and 845 ft West
of the Center of Section 24.

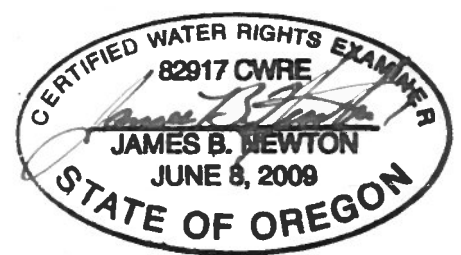

EXPIRES: 12-31-2010
RENEWS:

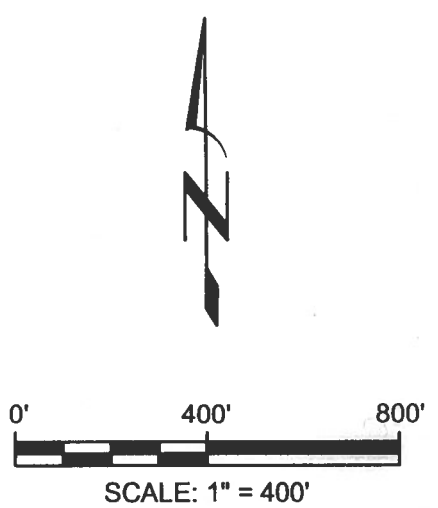


T14S, R14E, Section 24, Primary & Supplemental Rights

NOTES

THIS MAP WAS PREPARED FOR THE PURPOSE OF IDENTIFYING THE LOCATION OF WATER RIGHTS ONLY AND IS NOT INTENDED TO PROVIDE LEGAL DIMENSIONS OR LOCATIONS OF PROPERTY OWNERSHIP LINES.

RECEIVED
OCT 04 2010
WATER RESOURCES DEPT
SALEM OREGON

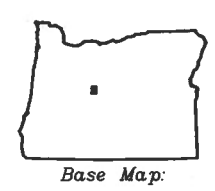

COBU MRP 0540


NEWTON CONSULTANTS INC.
Earth, Water and Rock Specialists
Ph: 541 504-9980 Fax: 541 504-9981

Claim of Beneficial Use, T-10233, Section 24 (W¹/₂)
River Run Ranch
Crook County, Oregon

DESIGNED BY: K. Turner	DRAWN BY: S. Schenck	DATE: Oct 2010	PROJECT NO. 1018-102	FIGURE 9
---------------------------	-------------------------	-------------------	-------------------------	-------------

0540
50fs

C:\1000\1018\102\Cad\Water\1018102_F2_COBU_A 14:55 09/30/2010 SS

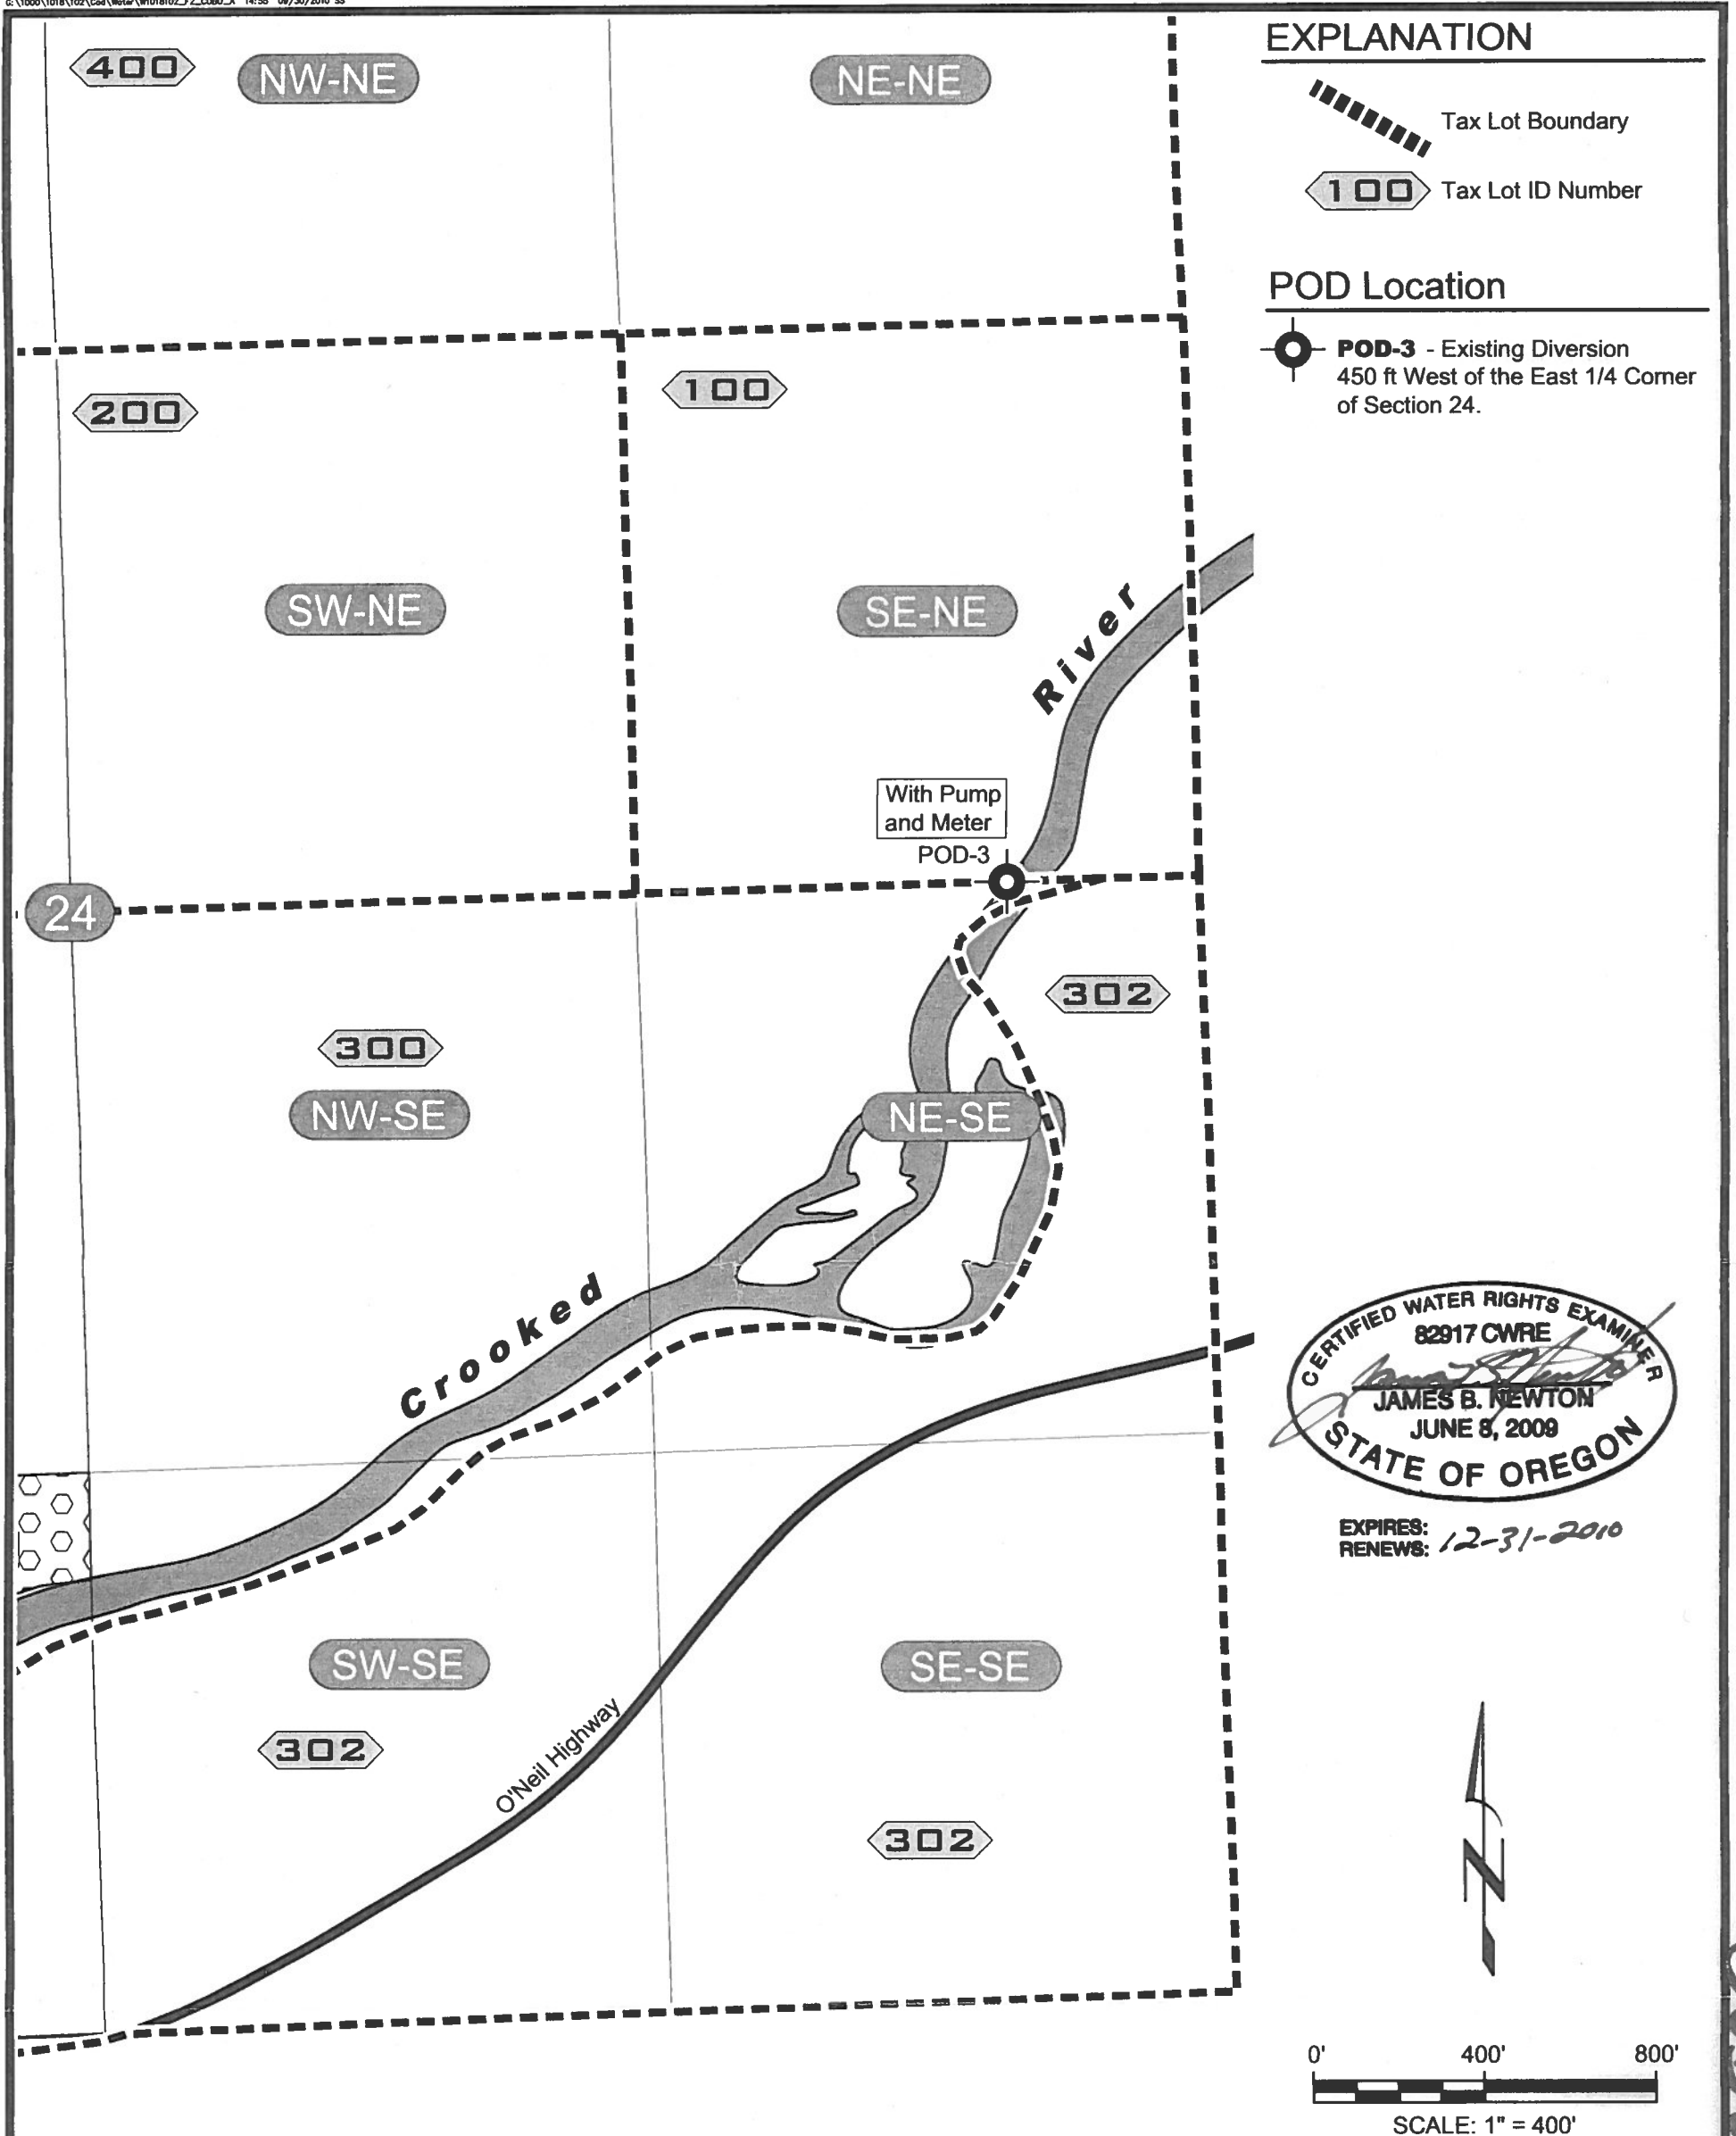

T14S, R14E, Section 24, POD #3

NOTES

THIS MAP WAS PREPARED FOR THE PURPOSE OF IDENTIFYING THE LOCATION OF WATER RIGHTS ONLY AND IS NOT INTENDED TO PROVIDE LEGAL DIMENSIONS OR LOCATIONS OF PROPERTY OWNERSHIP LINES.

RECEIVED

OCT 04 2010

WATER RIGHTS DEPT
SALEM, OREGON



Base Map:

NEWTON
CONSULTANTS INC.
Earth, Water and Rock Specialists
Ph: 541 504-9980 Fax: 541 504-9981

POD #3 - Claim of Beneficial Use, T-10233, Section 24 (E $\frac{1}{2}$)
River Run Ranch
Crook County, Oregon

DESIGNED BY: K. Turner	DRAWN BY: S. Schenck	DATE: Oct 2010	PROJECT NO. 1018-102	FIGURE 10
---------------------------	-------------------------	-------------------	-------------------------	--------------

COBU MAP 0542