


T.13S., R.27E., W.M.

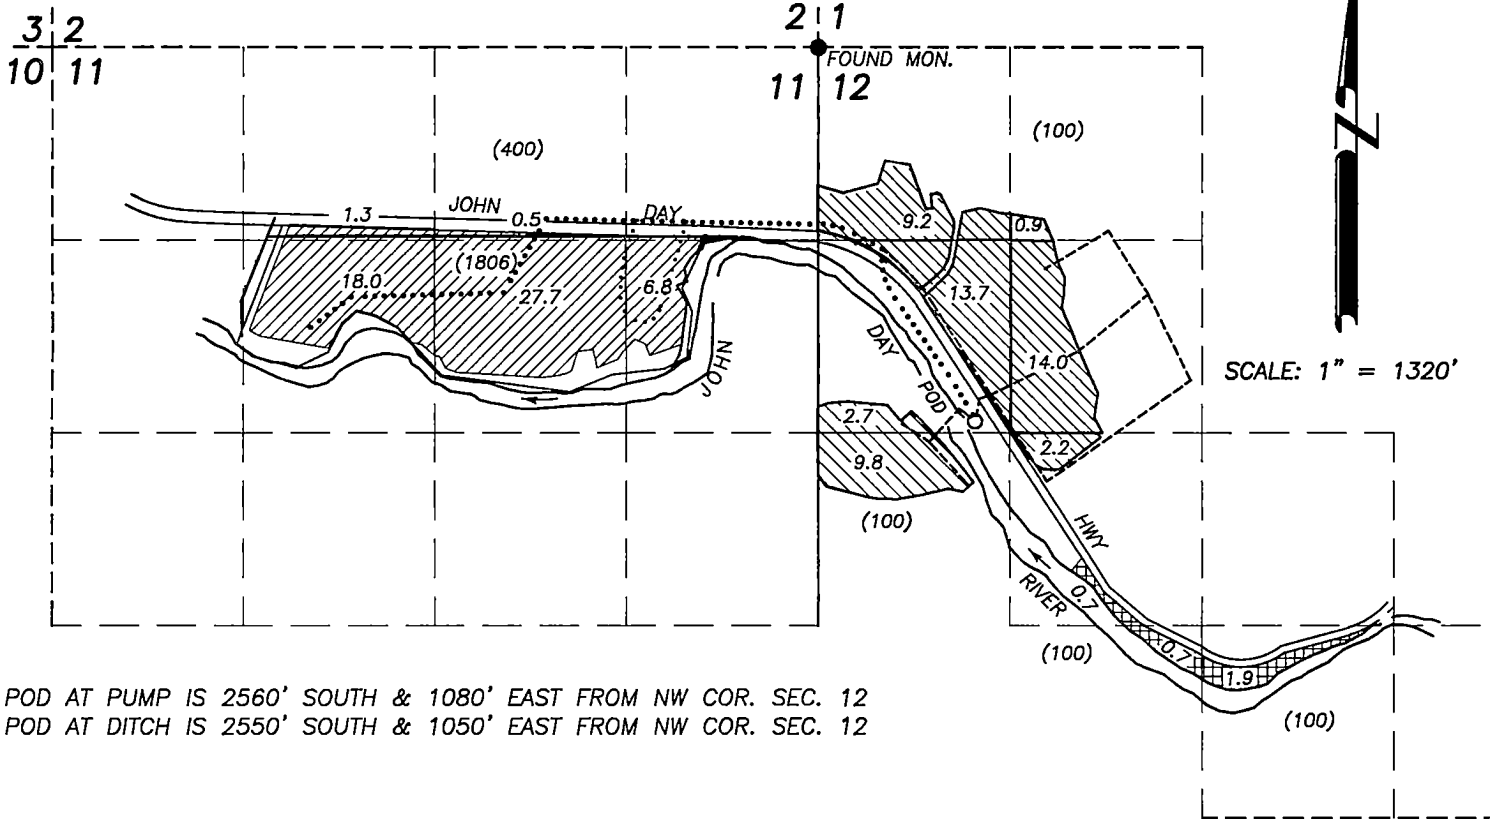

POD AT PUMP IS 2560' SOUTH & 1080' EAST FROM NW COR. SEC. 12  
 POD AT DITCH IS 2550' SOUTH & 1050' EAST FROM NW COR. SEC. 12




**FINAL PROOF SURVEY  
 UNDER  
 APPLICATION NO. T-9551  
 PERMIT NO. SPECIAL ORDER  
 VOL. 59, PAGE 116**

**IN NAME OF  
 RUSSELL YOUNG  
 BY**

**ROBERT D. BAGETT  
 217 N. CANYON BLVD.  
 JOHN DAY, OREGON 97845  
 (541) 575-1251**

NOVEMBER 21, 2014


REVISED: NOVEMBER 9, 2018

- POD
- MAINLINE
- ..... DITCH
- ( ) TAX LOT NO.
-  PLACE OF USE C-57837
-  PLACE OF USE C-64186
-  PLACE OF USE C-25853

**RECEIVED**

NOV 15 2018

**OWRD**

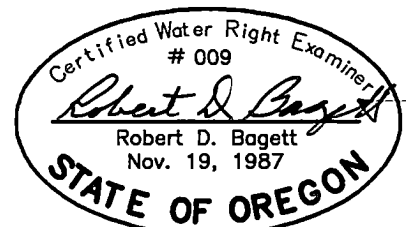

DISCLAIMER: THIS MAP IS NOT INTENDED TO PROVIDE LEGAL DIMENSIONS OR LOCATIONS OF PROPERTY OWNERSHIP LINES.

RENEWS: 12/31/2019