


T.13S., R.27E., W.M.

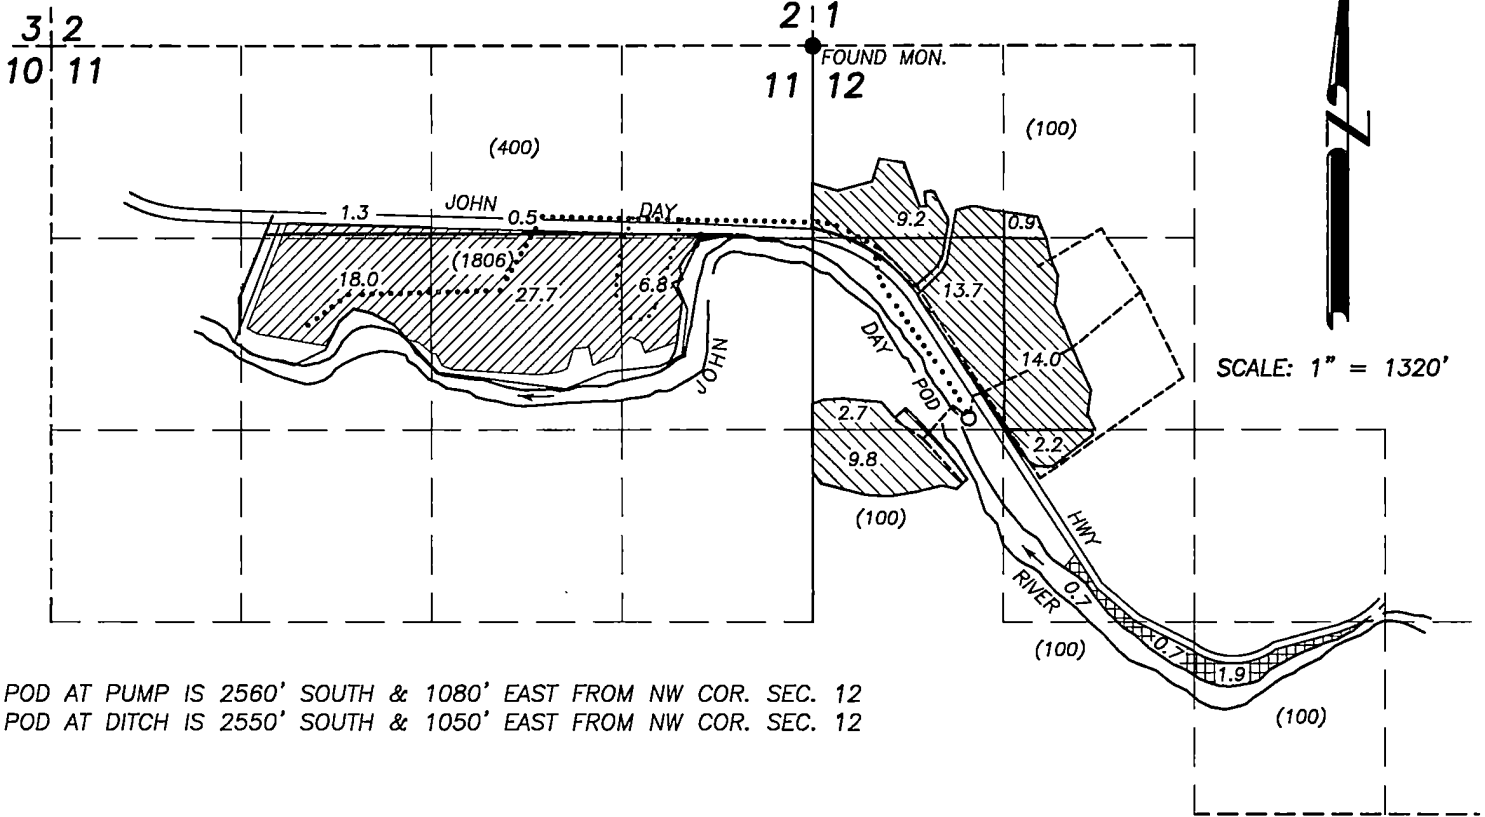

POD AT PUMP IS 2560' SOUTH & 1080' EAST FROM NW COR. SEC. 12
 POD AT DITCH IS 2550' SOUTH & 1050' EAST FROM NW COR. SEC. 12

**FINAL PROOF SURVEY
 UNDER
 APPLICATION NO. T-9551
 PERMIT NO. SPECIAL ORDER
 VOL. 59, PAGE 116**

**IN NAME OF
 RUSSELL YOUNG
 BY**

**ROBERT D. BAGETT
 217 N. CANYON BLVD.
 JOHN DAY, OREGON 97845
 (541) 575-1251**

NOVEMBER 21, 2014


REVISED: NOVEMBER 9, 2018

- POD
- MAINLINE
- DITCH
- () TAX LOT NO.
- PLACE OF USE C-57837
- PLACE OF USE C-64186
- PLACE OF USE C-25853

RECEIVED

NOV 15 2018

OWRD

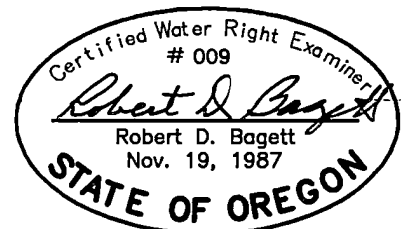

DISCLAIMER: THIS MAP IS NOT INTENDED TO PROVIDE LEGAL DIMENSIONS OR LOCATIONS OF PROPERTY OWNERSHIP LINES.

RENEWS: 12/31/2019