


CLAIM OF BENEFICIAL USE MAP
NW 1/4 Section 24, T.29S. R.17E., W.M.
 Lake County, Oregon


Transfer 11911

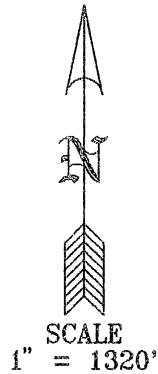



RECEIVED BY OWRD

OCT 08 2015

SALEM, OR

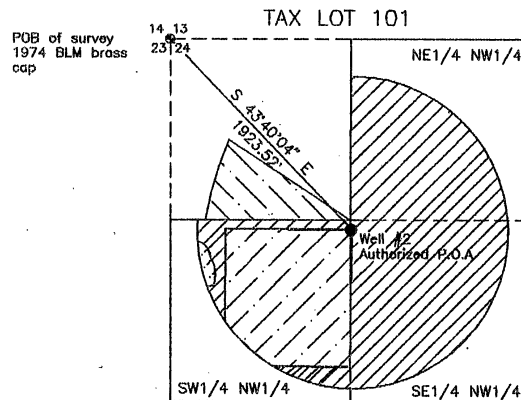


Measuring device is in pipe
between well & pivot

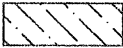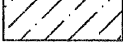-  7.34 Acres irrigated
Transfer 11911
-  52.42 Acres irrigated
Certificate 89770
-  20.97 Acres irrigated
Certificate 87464

Prepared for: Ernest D. & Dixie Shuffield
 Chaylon & Amber Shuffield
 Prepared by: Sundet & Associates
 P.O. Box 1228
 Lakeview, OR 97630

May 2015 DR #1419

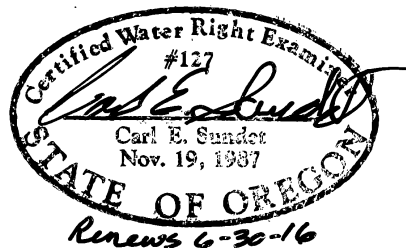

This map is for the purpose of identifying the location
 of the water right only and is not intended to provide
 legal dimensions or location of property ownership lines.