


Authorized Well (CLAC 56080) is located 454 feet north and 1,591 feet east from the SW corner, Section 10.

 Area (6.44 Acres) irrigated under Certificate 87775, priority date August 14, 2001, not affected by this transfer.

 Area (9.56 Acres) irrigated under Certificate 87775, priority date August 14, 2001, affected by this transfer.

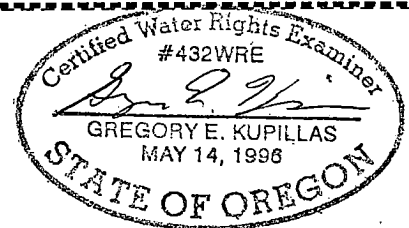

EXPIRATION DATE: 6/30/2019

RECEIVED

MAR 23 2018


OWRD

----- Tax lot boundary

 Donation Land Claim boundary

..... Water main line

Scale: 1" = 400'

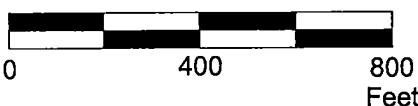

This map was prepared for the purpose of identifying the location of a water right only and is not intended to provide legal dimensions or location of property ownership lines.

# Transfer Application Map Certificate 87775

Horta Latitude 45, LLC c/o George Xidias  
T.4S. R.1E Section 10. W.M.

**Pacific Hydro-Geology Inc.**

03/2018



SECTION 10, T.4S, R.1E, W.M.

CLACKAMAS COUNTY, OREGON

RECEIVED

APR 06 2012

WATER RESOURCES DEPT  
SALEM, OREGON

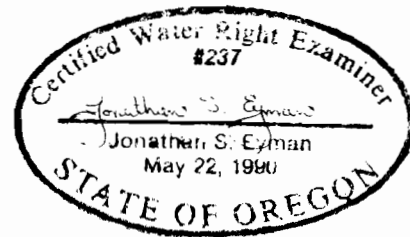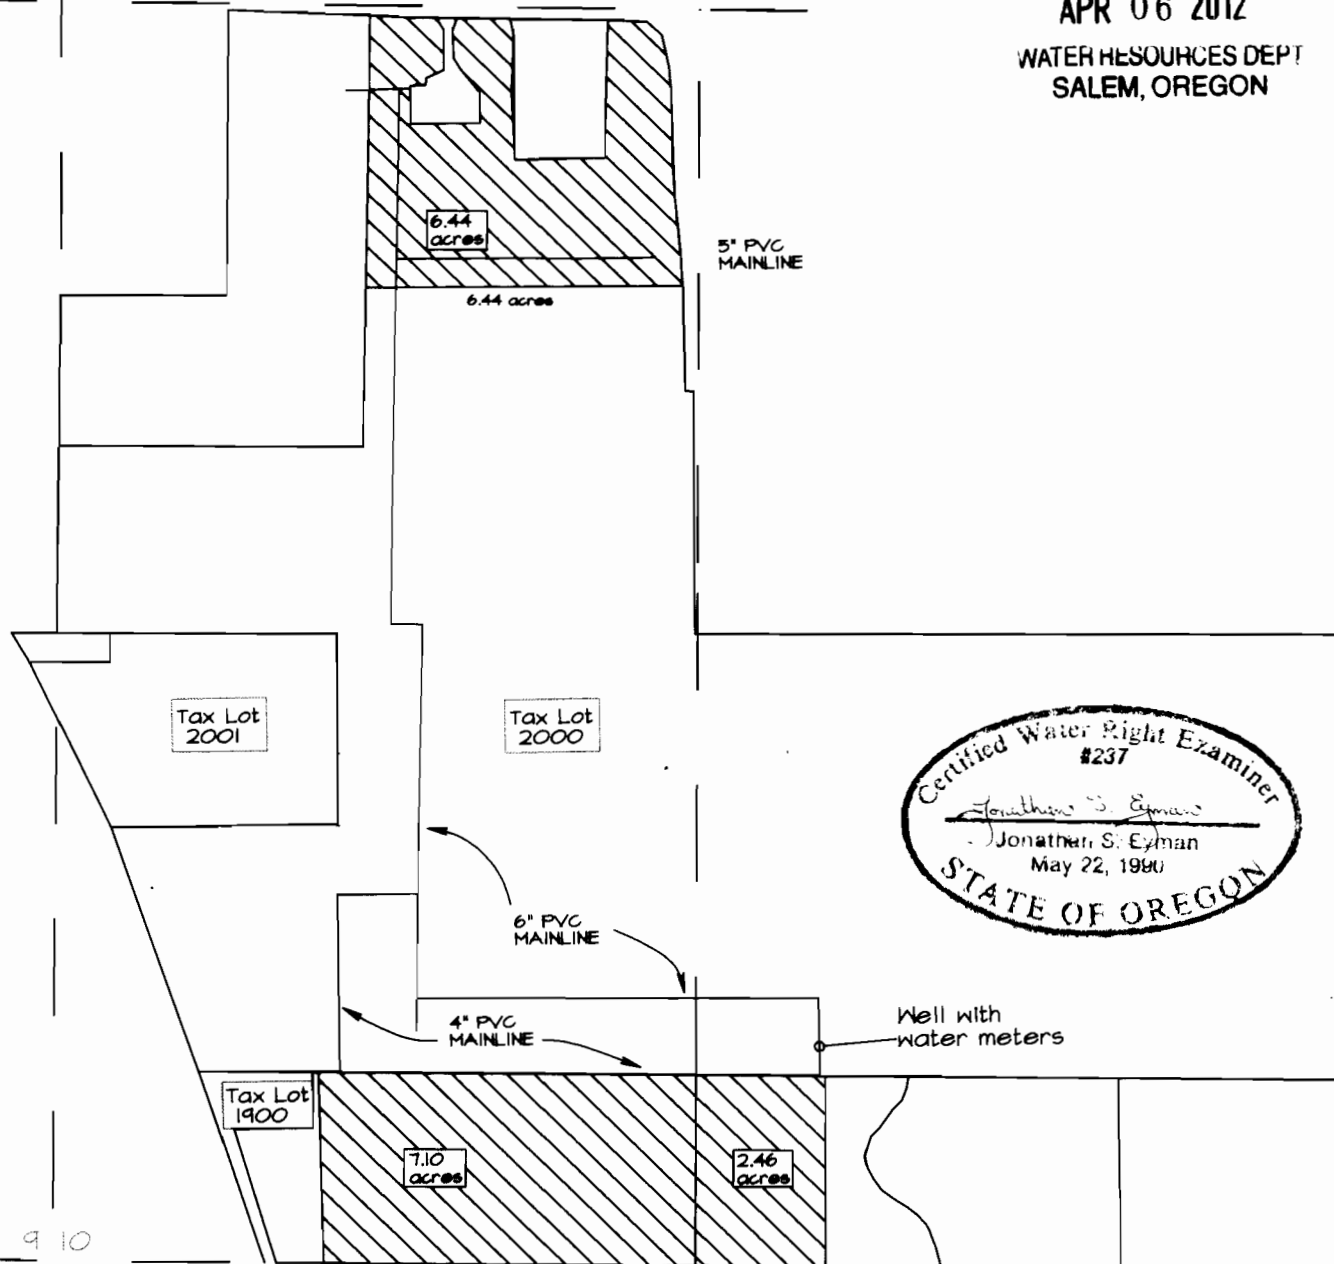

THE WELL IS 1591 FEET EAST AND 454 FEET NORTH OF THE SW CORNER OF SECTION 10  
THE WATER METERS ARE LOCATED AT THE WELL.

SCALE: 1" = 400'

CLAIM OF BENEFICIAL USE MAP  
ALLEN KRAXBERGER, JR.

APPLICATION NO. G-15582

PERMIT NO. G-15003

PERMIT AMENDMENT NO. T-10843



IRRIGATED AREA  
PORTION OF TL 1900  
& TL 2000  
(16.0 ACRES)

THE PREPARATION OF THIS MAP IS FOR THE  
PURPOSE OF IDENTIFYING THE LOCATION  
OF THE WATER RIGHT ONLY AND HAS NO  
INTENT TO PROVIDE DIMENSIONS OR LOCATION  
OF PROPERTY OWNERSHIP LINES

6150101500CLIENT 09/29/2012  
2012\_G15582\_COBU\_3 04/08/2012