


Section 33, T7S, R44E, W.M.,
Baker County, Oregon

Application S-72113, Permit S-52455
AMENDED CLAIM OF BENEFICIAL USE MAP
Phillips Ranches, Inc. & Ellingson Lumber Co.

RECEIVED

DEC 04 2018

OWRD

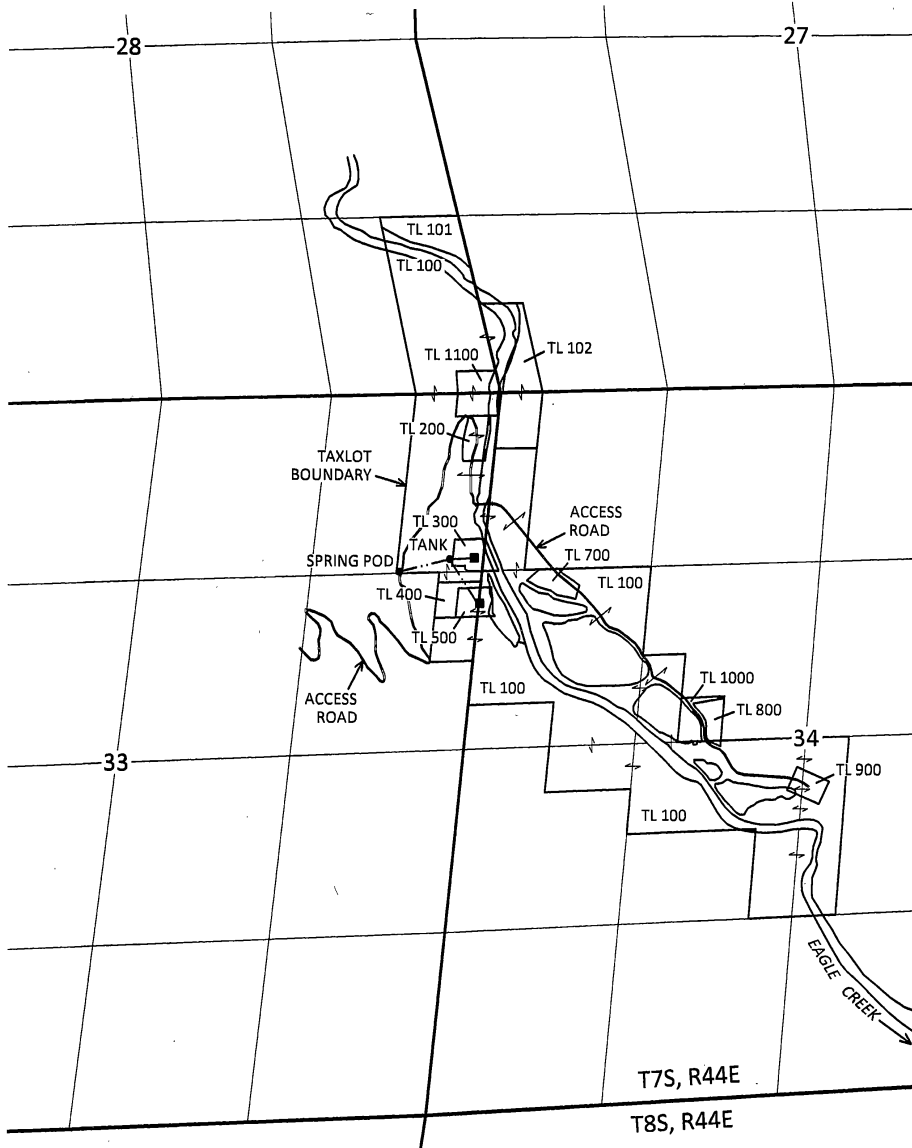

EXPLANATION

- SPRING POD / TANK
- PLACE OF USE (HOUSE)
- PIPELINE (APPROXIMATE)

SPRING POD LOCATED 1310 FT S AND 740 FT W
FROM THE NE CORNER OF SECTION 33

SITE INSPECTION CONDUCTED
AUGUST 14, 2014

NOTE: MAP AMENDED TO SHOW A CHANGE
IN THE TAX LOT 500 BOUNDARY



SCALE



1 INCH = 1320 FEET

November 26, 2018

This map is not intended to provide legal
dimensions or locations of property
ownership lines

SKOOKUM
WATER ASSOCIATES INC

P.O. BOX 80174
PORTLAND, OR 97280
(503) 319-8926

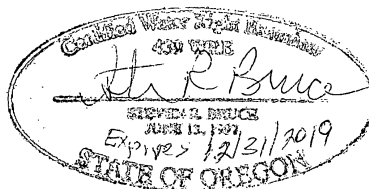


Figure 1