


SCALE: 1"=1320'

WELL GPS POSITION

LAT: 45°18'22.68303" N
LONG: 118°03'34.88161" W

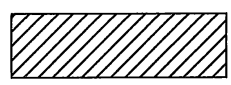


Lands irrigated from existing well.

RECEIVED BY OWRD

JUN 22 2015

SALEM, OR

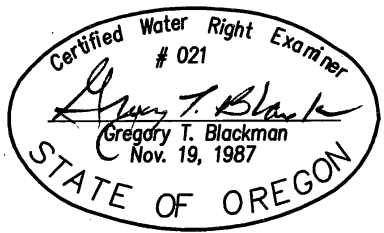

May 28, 2015
CLAIM OF BENEFICIAL USE MAP
FOR LANDS IRRIGATED UNDER
G-15404
FOR
RON & CHLOE LARVIK

BY
BAGETT - GRIFFITH & BLACKMAN
2006 ADAMS AVENUE
LAGRANDE, OREGON 97850

NOTE: The preparation of this map was for the purpose of identifying the location of the proposed water right and has no intent to provide dimensions or location of property ownership lines. Location information shown hereon was furnished by the applicant.

Application No. G-15320
Permit Number G-15404