


TOWNSHIP 16 SOUTH, RANGE 4 WEST, W.M.

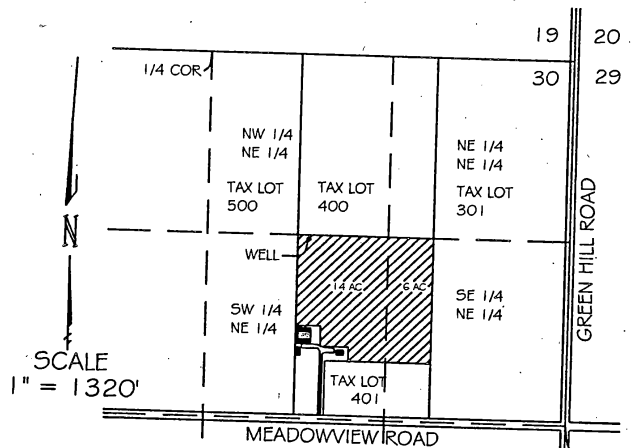

APPLICATION G=15160 PERMIT G-14070


WELL LOCATION:
1350' FEET SOUTH &
1900 FEET WEST OF
NE CORNER SECTION 30

FINAL PROOF SURVEY
FOR
DONALD & KIRSTI HADDEN
28763 MEADOWVIEW ROAD
JUNCTION CITY, OREGON 97448
541-461-3376

BY
H. TIMOTHY FASSBENDER
2896 SARAH LANE
EUGENE, OR 97401
541-485-3136
SEPTEMBER 27, 2006

NOTE:
THIS MAP IS NOT INTENDED
TO PROVIDE LEGAL DIMENSIONS
OR LOCATIONS OF PROPERTY
OWNERSHIP LINES.

 DENOTES WATER USAGE LOCATION
 DENOTES BUILDING LOCATION

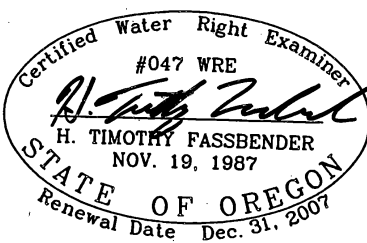

RECEIVED

FEB 21 2007

WATER RESOURCES DEPT
SALEM, OREGON