


CLAIM OF BENEFICIAL USE MAP
FOR DAVIS FAMILY TRUST
LOCATED IN THE NE1/4 OF THE SE1/4 OF SECTION 21
TOWNSHIP 23 SOUTH, RANGE 12 WEST, W.M.,
COOS COUNTY, OREGON

APPLICATION #S-83456
PERMIT #53396

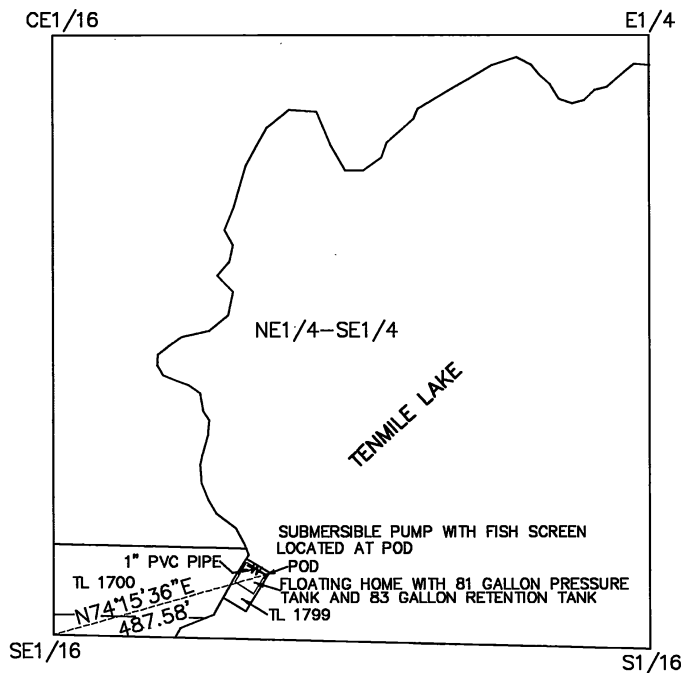


SCALE 1" = 400'
DATE 8/21/14

WGS84 LAT. & LONG. FOR POD
N 43°33'25.7"
W 124°07'28.9"

LEGEND:

- POD POINT OF DIVERSION
- TL TAX LOT
- w— WATER PIPE LINE

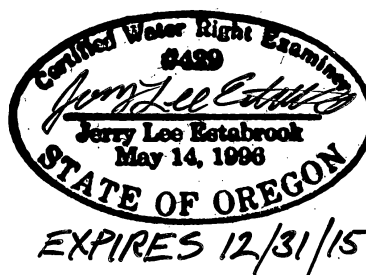

RECEIVED BY OWRD

SEP 02 2014

SALEM, OR

EXAMINERS DISCLAIMER STATEMENT:

THE PREPARATION OF THIS MAP WAS FOR THE PURPOSE OF IDENTIFYING THE LOCATION OF WATER RIGHT ONLY AND HAS NO INTENT TO PROVIDE DIMENSIONS OR LOCATION OF PROPERTY OWNERSHIP LINES.