




LEGEND

- SECTION LINE
- 1/4 1/4 LINE
- TAX LOT LINE
- 2.0 NWNE IRRIGATED ACREAGE
- 1/4 1/4 SECTION
- ⊙ POA (WELL)
- ▨ IRRIGATED AREA
- TL 901 TAX LOT NUMBER
- Ⓜ METER

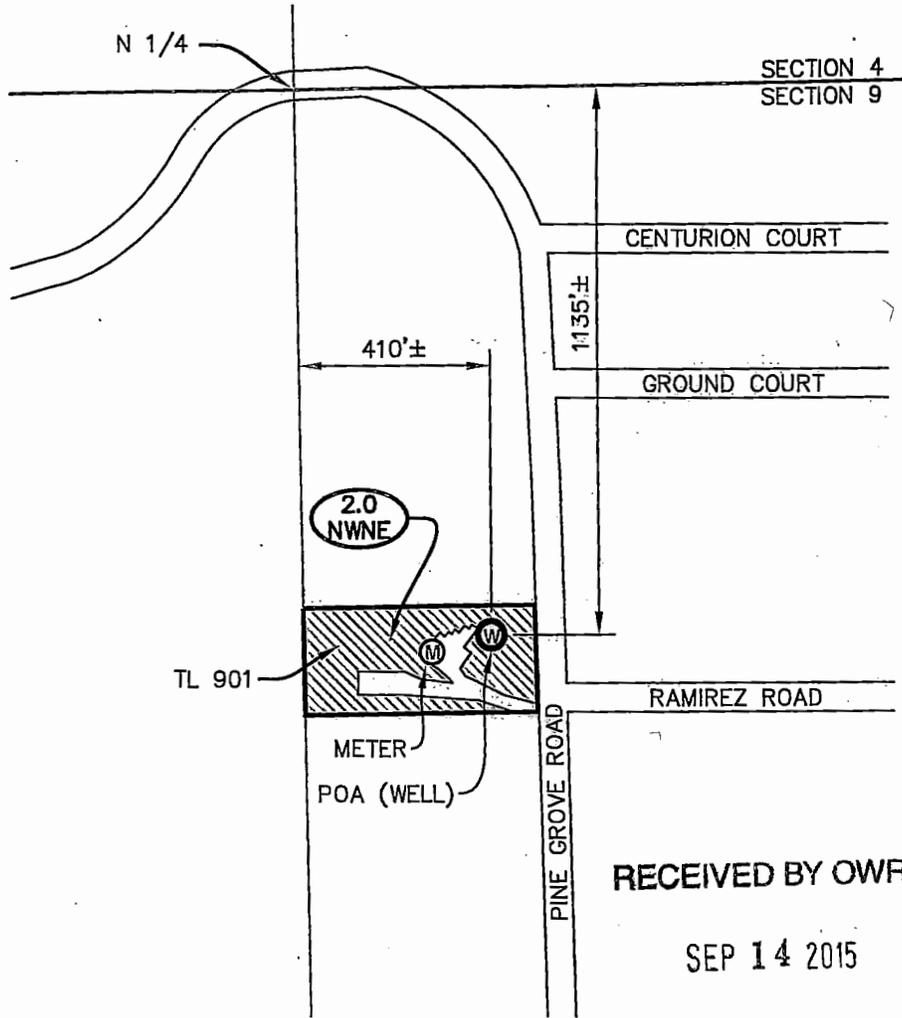

RECEIVED BY OWRD
 SEP 14 2015
 SALEM, OR


WELL TIES

POA (WELL): 1135' SOUTH & 410' EAST FROM THE NORTH 1/4 CORNER OF SECTION 9.

NOTES

1. THIS MAP WAS PREPARED FROM FIELD MEASUREMENTS, 2014 NAIP AERIAL IMAGERY, AND KLAMATH COUNTY TAX MAP T39S, R10E, SEC. 9.
2. THIS MAP IS FOR THE PURPOSE OF IDENTIFYING THE LOCATION OF THE WATER RIGHT ONLY AND HAS NO INTENT TO PROVIDE LEGAL DIMENSIONS OR LOCATION OF PROPERTY OWNERSHIP LINES.
3. FOR TAX LOT INFORMATION, SEE TAX MAP 39 10 09AB INCLUDED WITH THIS COBU.
4. DATE OF PRIORITY FOR THIS CLAIM IS JANUARY 5, 1981.

John M. Bailey
Sharon R. Bailey
 APPLICANT

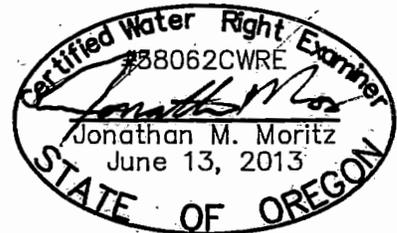

RENEWAL 12/31/16

ADKINS



CONSULTING ENGINEERING, LLP
 Engineers ▲ Planners ▲ Surveyors
 2950 Shasta Way · Klamath Falls, Oregon 97603 · (541) 884-4666 · FAX (541) 884-5335
 Oregon · California

CLAIM OF BENEFICIAL USE AND FINAL PROOF MAP

FOR
 JOHN MICHAEL AND SHARON RENEE BAILEY
 T39S, R10E, SEC. 9, W.M.
 KLAMATH COUNTY, OREGON
 PERMIT No. G-9206
 TRANSFER No. T-11156