



T.4S. R.1W. Sec. 36, W.M. & T.4S. R.1E. Sec. 31, W.M.

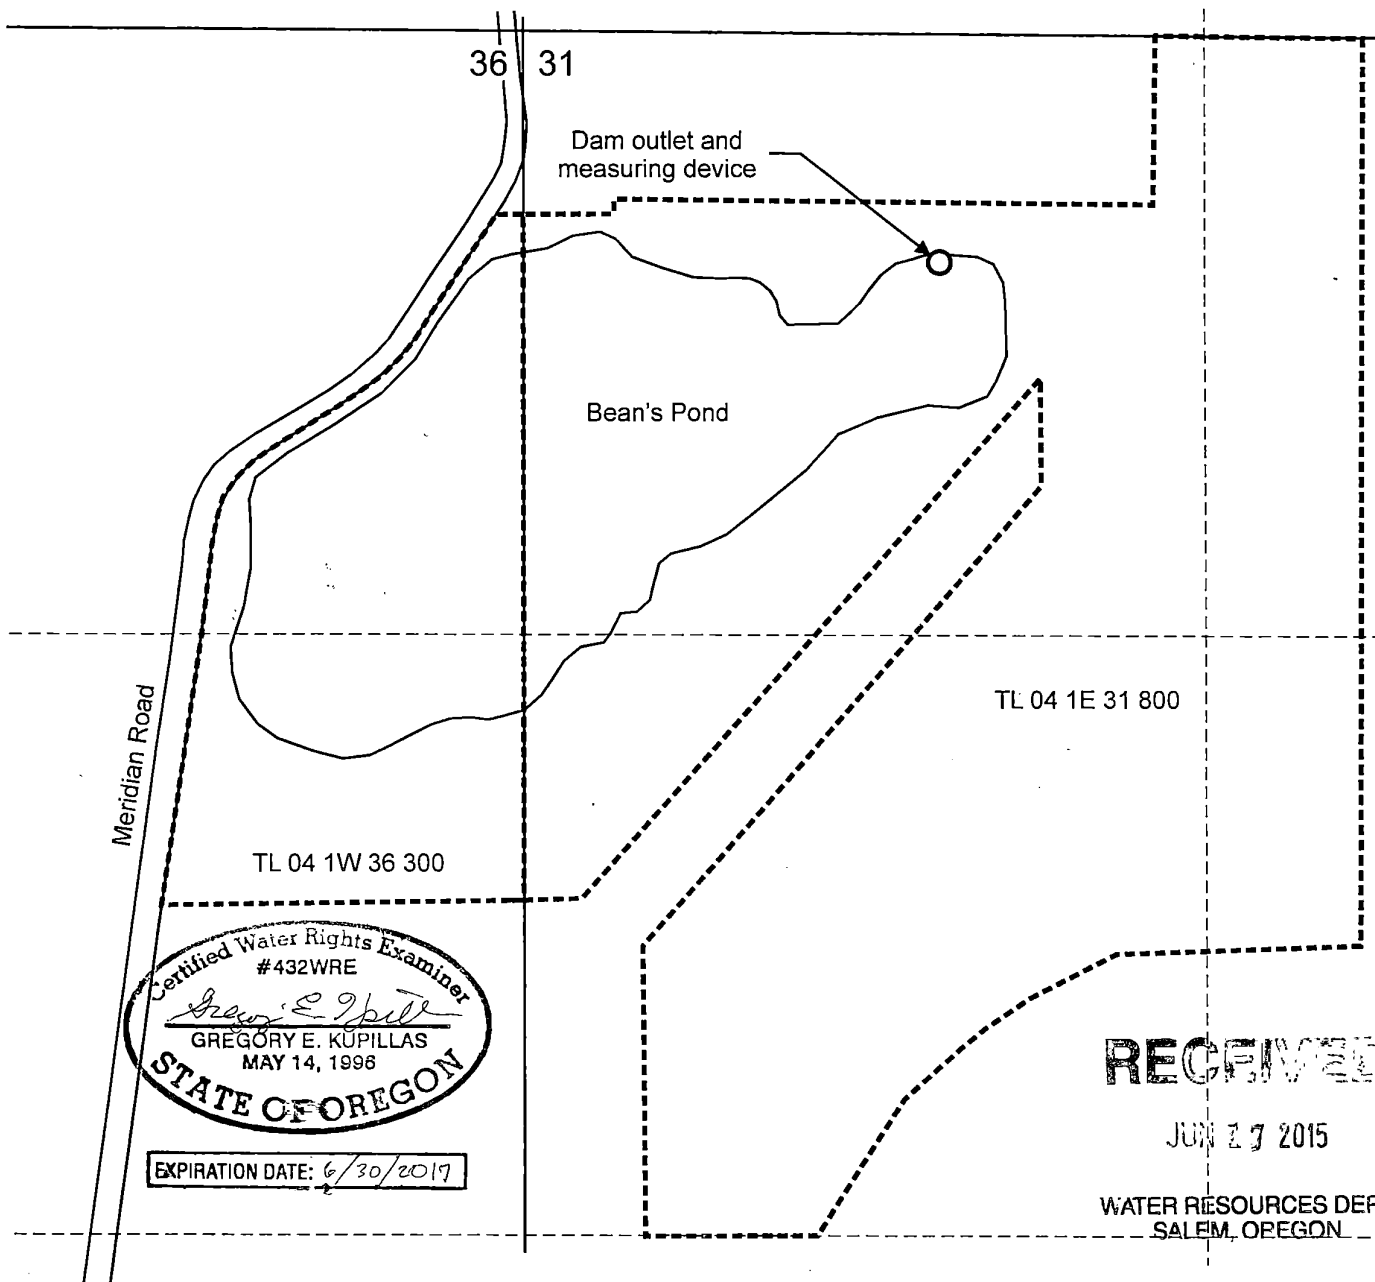

Dam outlet and measuring device (trickle tube) are located 510 feet south and 910 feet east from the NW Corner, Section 31.

----- Tax lot boundary

Scale: 1" = 400'

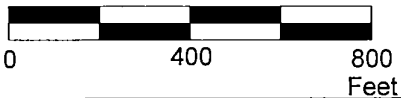

This map was prepared for the purpose of identifying the location of a water right only and is not intended to provide legal dimensions or location of property ownership lines.



Claim of Beneficial Use Map
Application R-84020, Permit R-12679

Warren Bean

T.4S. R.1W. Sec. 36, W.M. &
2015 - bgp T.4S. R.1E. Sec. 31, W.M.

Pacific Hydro-Geology Inc.