


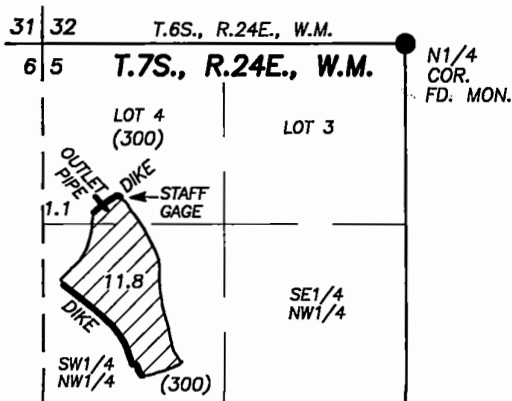

SCALE: 1"=1320'

FINAL PROOF SURVEY
 UNDER
 APPLICATION R-87609
 PERMIT R-14919
 IN NAME OF
THREE VALLEYS RANCH, LLC

RECEIVED BY OWRD

JUN 17 2015

SALEM, OR

MIDDLE CENTERLINE OF NORTH DIKE AT OUTLET PIPE IS 1150 FT.
 SOUTH & 2200 FT. WEST FROM N1/4 COR. SEC. 5


MEASURING DEVICE: STAFF GAGE AT NE CORNER OF RESERVOIR
 BEARS N.65°E., 90 FT. FROM MIDDLE CENTERLINE OF NORTH DIKE.

 RESERVOIR (WINELAND LAKE)
 (300) TAX LOT NO.

PREPARED BY
 ROBERT D. BAGETT
 217 N. CANYON BLVD.
 JOHN DAY, OR 97845

DATE SURVEYED: NOV. 4, 2014

DISCLAIMER: THIS MAP IS NOT INTENDED TO PROVIDE LEGAL
 DIMENSION OR LOCATIONS OF PROPERTY OWNERSHIP LINES.

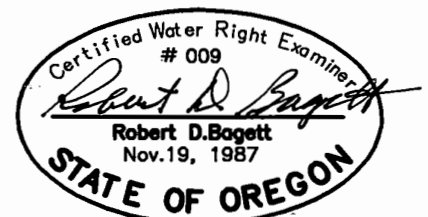

RENEWES: 12/31/2015