


T. 18 S., R. 32 E., W.M.
GRANT COUNTY, OREGON

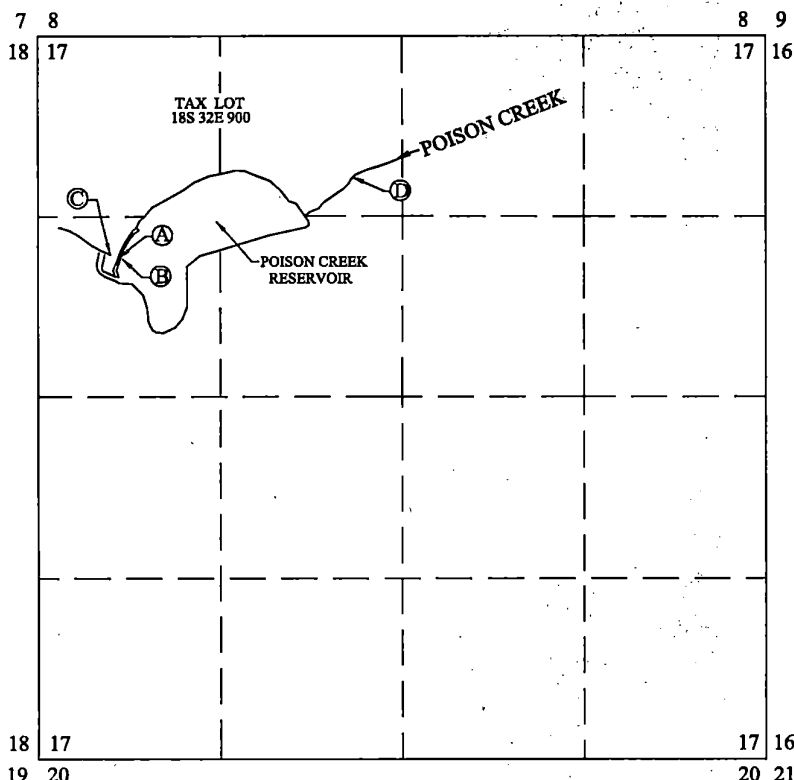

STRUCTURE LOCATIONS

DIMENSIONS AS SHOWN ARE FROM THE SOUTH 1/4 CORNER OF SECTION 15, T18S, R32E, W.M., GRANT COUNTY, OREGON. SOUTH 1/4 CORNER OF SECTION 15 IS MONUMENTED WITH A 2-1/2 INCH DIAMETER ALUMINUM PIPE WITH A 3-1/4 INCH DIAMETER ALUMINUM CAP AS SET BY F.E. CALKINS, PLS 1805, IN 1980.

- Ⓐ TOP CENTER OF DAM OVER OUTLET PIPE,
NORTH: 3,581 FEET
WEST: 12,618 FEET
- Ⓑ 18 INCH DIAMETER STEEL PIPE RISER,
NORTH: 3,572 FEET
WEST: 12,595 FEET
- Ⓒ END OF 12 INCH DIAMETER OUTLET PIPE ON DOWNSTREAM SIDE OF DAM,
NORTH: 3,605 FEET
WEST: 12,685 FEET
- Ⓓ CENTER AT WESTERLY END OF EZ FLOW RAMP FLUME,
NORTH: 4,173 FEET
WEST: 10,927 FEET

CLAIM OF BENEFICIAL USE MAP

FOR
POISON CREEK RESERVOIR

APPLICATION: R-83532

PERMIT: R-12527

IN THE NAME OF
UNITED STATES BUREAU OF LAND MANAGEMENT
BURNS DISTRICT

JULY 13, 2015

RECEIVED BY OWRD

AUG 03 2015


SALEM, OR



1 INCH = 1320 FEET



THE PURPOSE OF THIS MAP IS FOR IDENTIFYING THE LOCATION OF THE WATER RIGHT ONLY AND IS NOT INTENDED TO PROVIDE LEGAL DIMENSIONS OR LOCATIONS OF PROPERTY OWNERSHIP LINES.

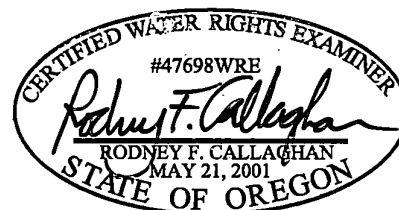

RENEWAL: 12/31/2015

U.S. BUREAU OF LAND MANAGEMENT
BURNS OREGON DISTRICT
DATED: JULY 13, 2015

PREPARED BY:
RODNEY F. CALLAGHAN, PLS, CWRE, CFeds
1301 SOUTH G STREET
LAKEVIEW, OR 97630