


CLAIM OF BENEFICIAL USE
FOR ROBERT AND JANET MOTT TAX LOT 2501
LAURAINNE CLEVELAND TAX LOT 2500
BY DUANE W. KIRBY
APPLICATION NO. S-84519
PERMIT NO. S-53762
FISH SCREEN IS AT THE POD
T26S, R6W, SEC 29

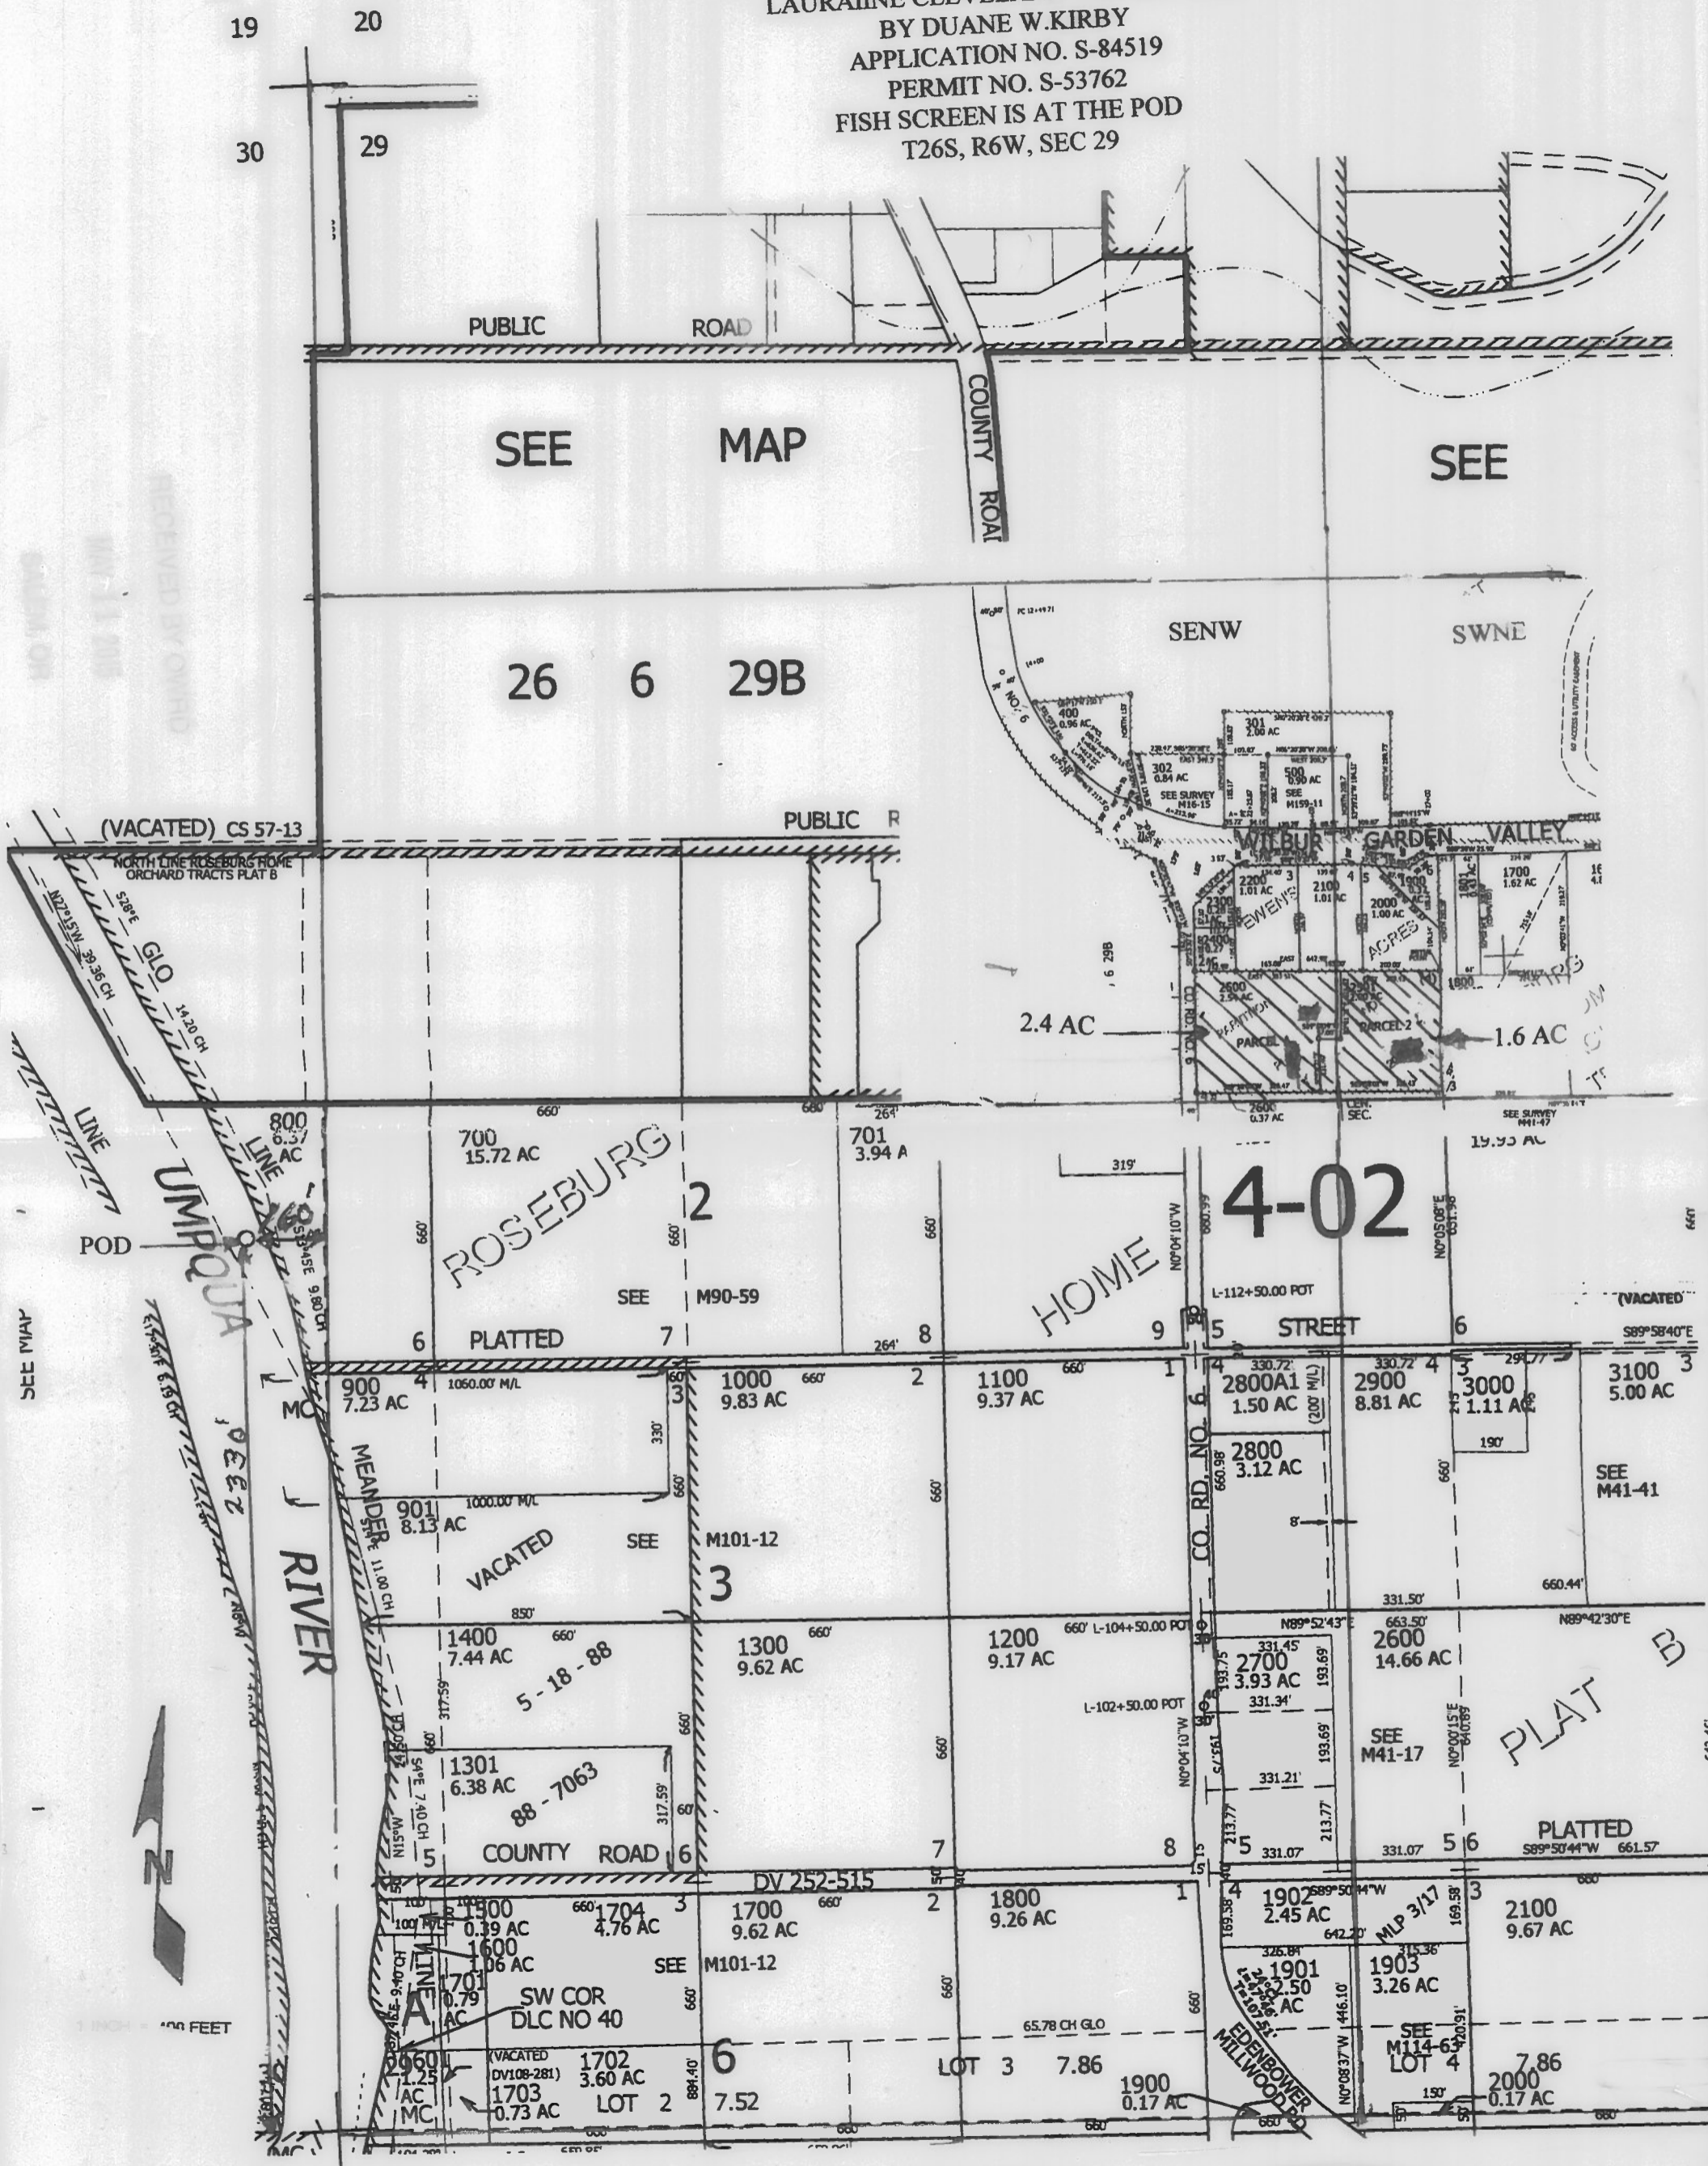

THE PURPOSE OF THIS MAP IS TO IDENTIFY THE LOCATION OF THE WATER RIGHT. IT IS NOT INTENDED TO PROVIDE INFORMATION RELATIVE TO THE LOCATION OF PROPERTY OWNERSHIP BOUNDARY LINES.

