


**T.15S., R12E., W.M.
SECTION 04**

Located in NE 1/4 SE 1/4 of Section 4, TAX LOT 15-12-04D0-100



RECEIVED

MAR 04 2011

WATER RESOURCES DEPT
SALEM, OREGON

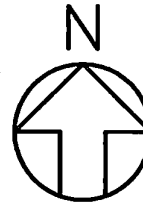

SCALE: 1" = 400'

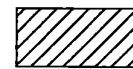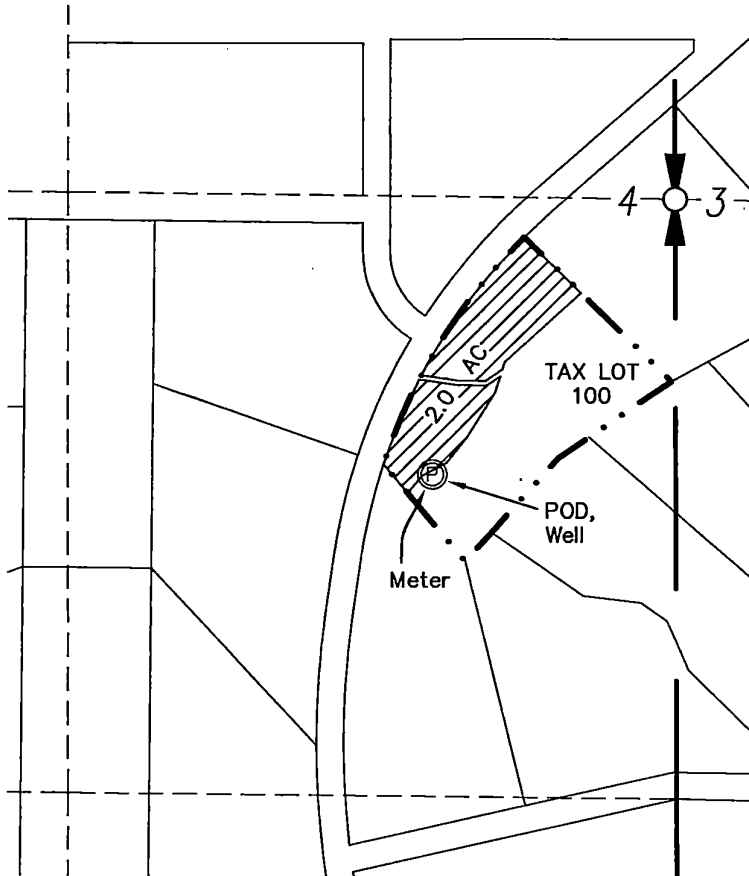

Place of Use

NE 1/4 SE 1/4 Section 04—
2.00 acres total



Point of Diversion,
POD, Well

— . . — Property Boundary

— — — Section Line

- - - - - 1/16th Section

— — — Tax Lot Line



CLAIM OF BENEFICIAL USE MAP

UNDER

Application No.G-16529 Permit No.G-16221

IN NAME OF

MARLON STEELE

Prepared: February 22, 2011 by Hickman Williams & Associates, Inc.
62930 O.B. Riley Road, Ste. 100, Bend, Oregon, 97701
Phone: 541-389-9351, Fax: 541-388-5416

This map is for the purpose of identifying the location of water right only and is not intended to provide legal dimensions or locations of property ownership lines.