

NOTES

1. THIS MAP WAS PREPARED FROM FIELD MEASUREMENTS, PLAT MAP OF MILLS ADDITION, AND KLAMATH COUNTY TAX MAP R-3809-033AC.
2. THE PURPOSE OF THIS MAP IS TO IDENTIFY THE LOCATION OF THE WATER RIGHT ONLY, AND IS NOT INTENDED TO PROVIDE DIMENSIONS OR LOCATION OF PROPERTY OWNERSHIP LINES.
3. FOR TAX LOT INFORMATION, SEE THE TAX MAP INCLUDED WITH THIS COBU.
4. DATE OF PRIORITY FOR THIS APPLICATION IS DECEMBER 17, 1990.

RECEIVED

OCT 29 2014

OWRD


Corporation of the Presiding Bishop of The Church of Jesus Christ of Latter-day Saints a Utah corporation sole.

Tony F. Reed
 APPLICANT

LEGEND

- POA-1 GEOTHERMAL SUPPLY WELL
- GEOTHERMAL INJECTION WELL
- TL500 TAX LOT NUMBER
- GEOTHERMAL HEATED BUILDING
- BURIED PIPE
- SITE BOUNDARY
- CENTERLINE R.O.W.
- RIGHT-OF-WAY LINE

AUTHORIZED AGENT

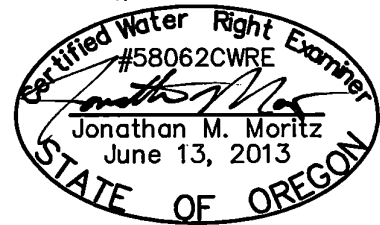

RENEWAL 12/31/14



2950 Shasta Way · Klamath Falls, Oregon 97603 · (541) 884-4666 · FAX (541) 884-5335
 Oregon · California

9-10-14

3176-02

CLAIM OF BENEFICIAL USE AND FINAL PROOF MAP

FOR
 CHURCH OF LATTER DAY SAINTS
 SW1/4 NE1/4, T38S, R9E, SEC. 33, W.M.
 KLAMATH COUNTY, OREGON
 APPLICATION No. G-12350
 PERMIT No. G-13350