

**CLAIM OF BENEFICIAL USE
TRANSFER T-12715**


Revised 8/27/2018

RECEIVED

AUG 31 2018

CHANGE IN PLACE OF USE
T 41 S, R 1 E, WM.
JACKSON COUNTY, OREGON

OWRD

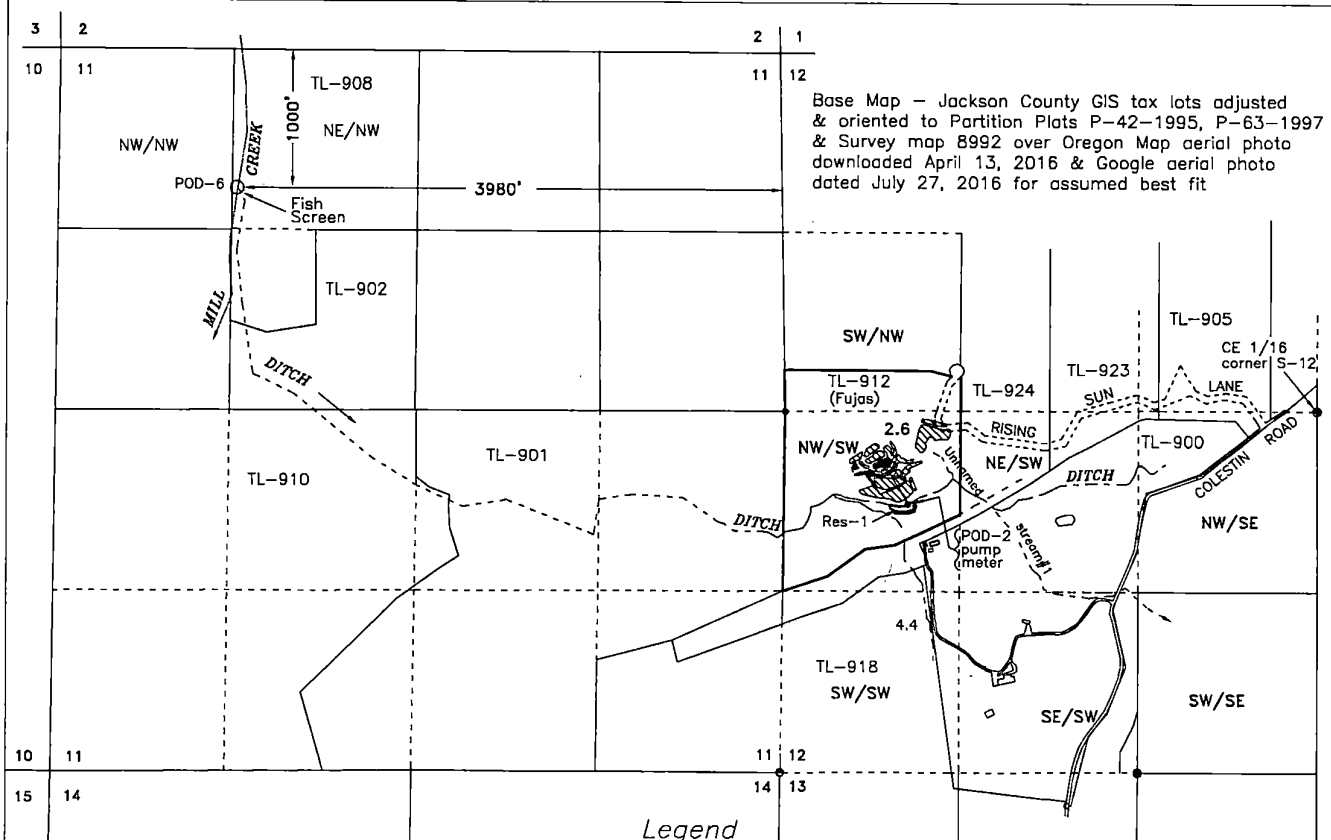

POD-6 Mill Creek - 1000 feet south & 3980 feet west from the NE corner section 11 (from FPS permit S-44755)

POD-2 - Pump - 690 feet south & 2975 feet west from the CE 1/16 corner section 12



Irrigation - 2.6 acres TL-912

• • Buildings

PREPARED FOR:

Fujas Family Trust
5128 South Pacific Highway
Phoenix, OR 97535

This map is not intended to provide legal dimensions or locations of property ownership lines

SCALE: 1" = 1320'


0' 660' 1320' 2640'

Prepared by:

FARBER & SONS, INC.
dba FARBER SURVEYING
(541) 664-5599

PO BOX 5286
431 OAK STREET
CENTRAL POINT, OREGON 97502

DATE: August 27, 2018 n.e.d.

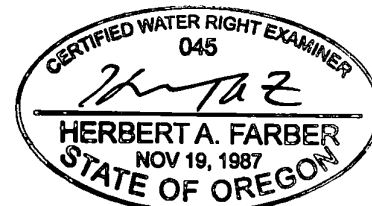

EXPIRES: 12/31/2019

Job No. 2017-2657