


**T26S, R34E,
SECTION 29, WM**

HARNEY COUNTY, OREGON

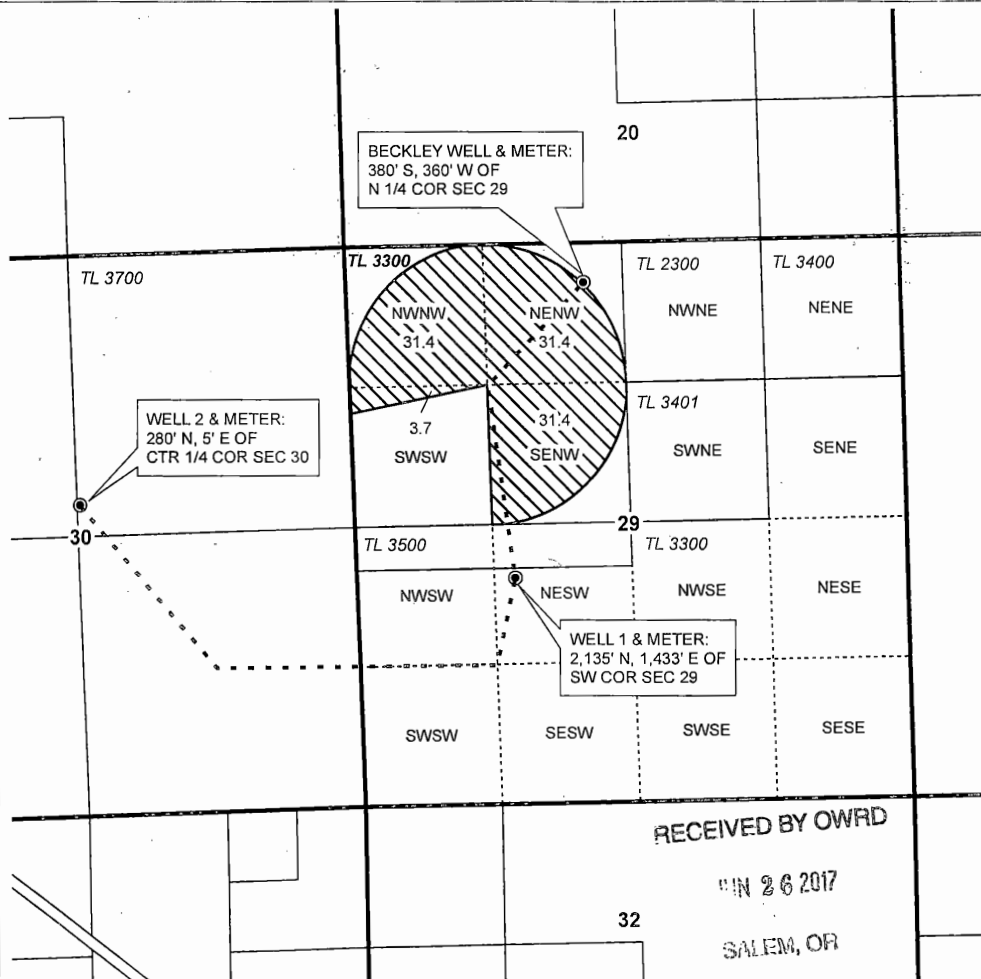


0 1,320 Feet
1" = 1,320'

- POU IR
- Section
- Quarter Quarter
- Tax Lot
- Well
- Buried Pipeline

RECEIVED BY OWRD


SALEM, OR

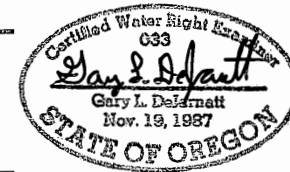

RENEWAL DATE 12/31/2017



CLAIM OF BENEFICIAL USE MAP
Sword Ranch

NOTE: THIS MAP IS NOT INTENDED TO
PROVIDE LEGAL DIMENSIONS OR LOCATIONS
OF PROPERTY OWNERSHIP LINES.

WATER RIGHT SERVICES, LLC

PO BOX 1830, BEND, OR 97709

CCB# 197121 www.oregonwater.us

541-389-2837 JOHNSHORT@USA.COM

AP G-1755

TRANSFER T-12357

JOB # 16070

APRIL 26, 2017