

FINAL PROOF SURVEY

Chouinard Family Trust

Robert Chouinard


Permit No. G-17026

Township 13 South, Range 27 East, Section 4 W.M.

RECEIVED

OCT 01 2018

OWRD

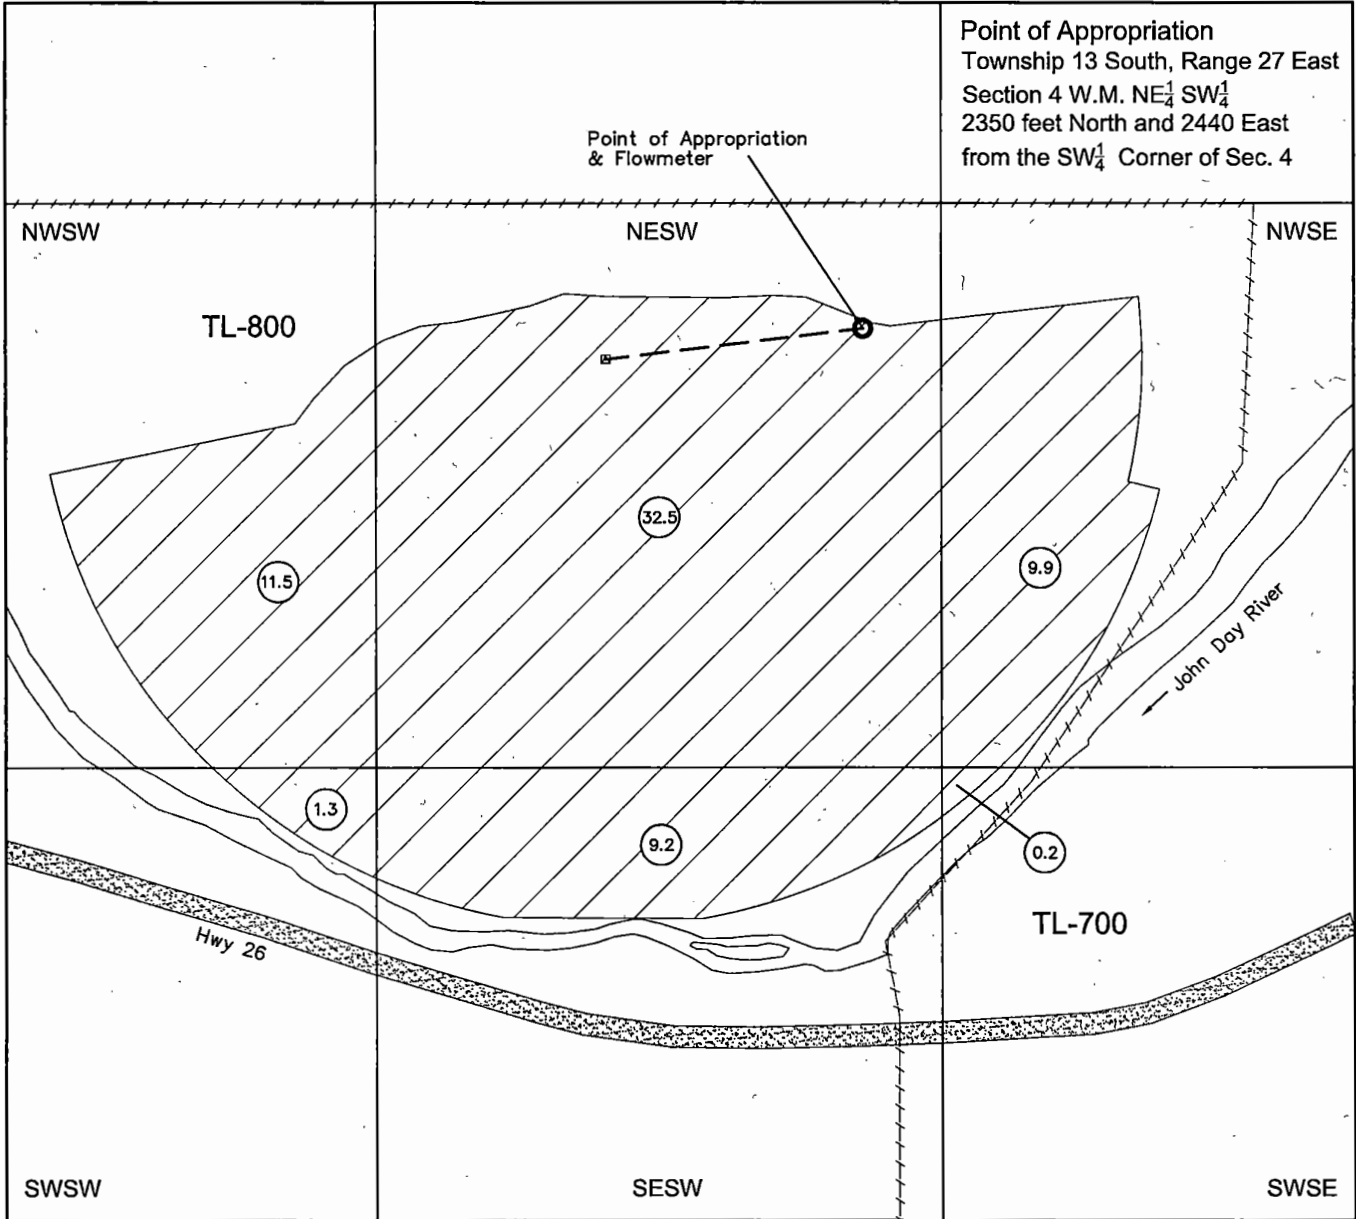


Point of Appropriation
Township 13 South, Range 27 East
Section 4 W.M. NE $\frac{1}{4}$ SW $\frac{1}{4}$
2350 feet North and 2440 East
from the SW $\frac{1}{4}$ Corner of Sec. 4

Scale: 1" = 400'

LEGEND

- Located Section Corner
- Irrigation Pipeline
- Property Boundary
- 2.1 Acres
- Irrigated Lands

This map is not intended to provide legal dimensions or location of property ownership lines.

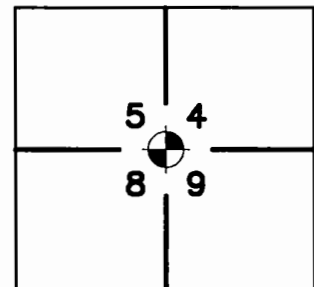

RENEWS: 6/30/20