



T9S, R40E, Section 9, Willamette Meridian

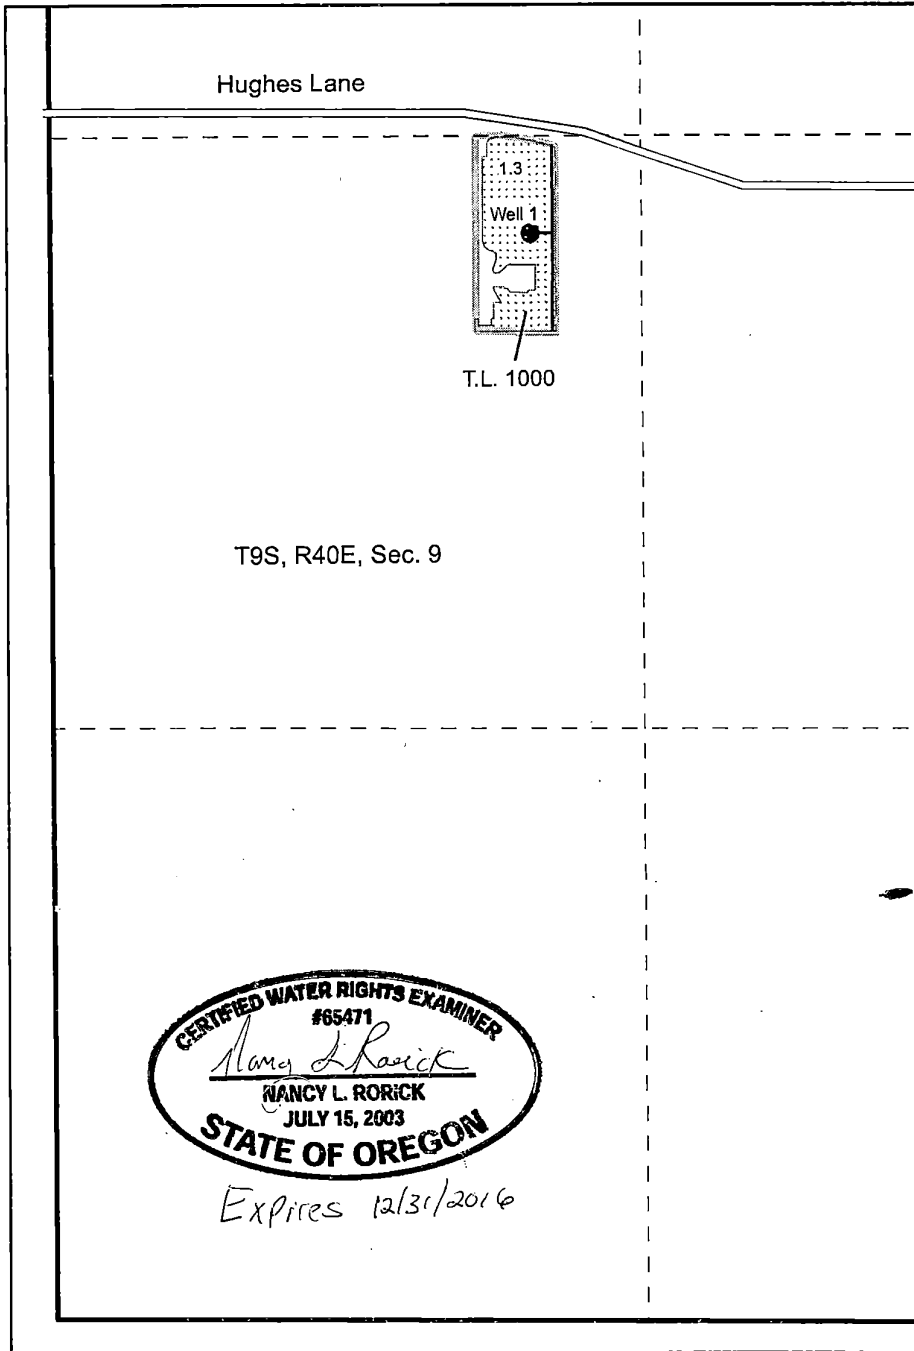

CERTIFIED WATER RIGHTS EXAMINER  
#65471  
*Nancy L. Rorick*  
NANCY L. RORICK  
JULY 15, 2003  
STATE OF OREGON  
*Expires 12/31/2016*

- Well
- ▨ Permit G15230 (Priority March 20, 2002)
- 2-inch PVC mainline
- Road
- - Quarter quarter line
- Section line
- ▨ Tax lot line

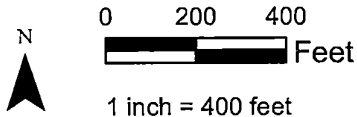

Well 1 is located in the NW SW of Section 9, T9S, R40E; and 1,050 feet east and 2,400 feet north of the SW corner of Section 9.

This map is not intended to provide legal dimensions or locations of property ownership lines.

Claim of Beneficial Use Map  
prepared for Thomas Beaver  
Permit G15230 and Application G15727  
Tax Lot 1000, Baker County

map prepared by Nancy Rorick Consulting