


FINAL PROOF MAP
 APPLICATION S-84609 - PERMIT S-53790
 GOVT. LOT 5 (SE1/4SE1/4) SECTION 21, T.34S., R.1W., W.M.
 JACKSON COUNTY, OREGON
 FOR
 SHERBOURNE LIVING TRUST DATED JANUARY 31, 2003
 MARK WILLIAM SHERBOURNE, TRUSTEE
 P.O. BOX 3157. McCALL, ID 83638

T.34S, R.1W.

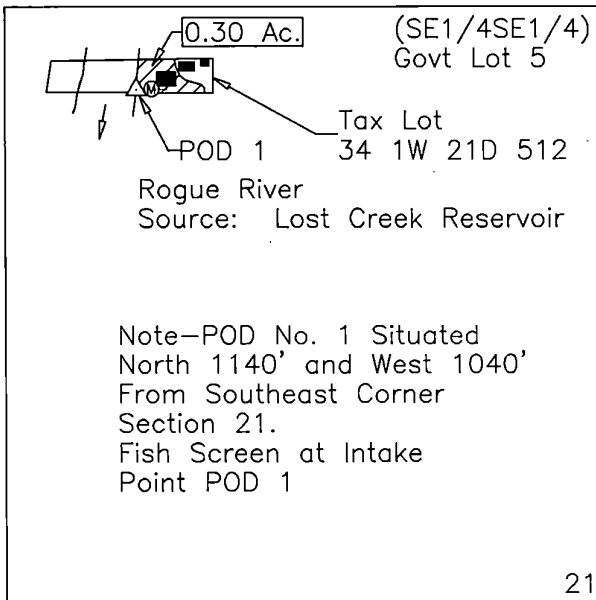


21 22
28 27



Scale: 1"=400'
 Date: June 27, 2015

LEGEND

- Found Survey Monument
- Denotes Building
- ▨ Denotes Area Under Permit S-53790 11/24/2000 Priority Date
- △ Denotes Point of Diversion
- Ⓜ Denotes Flow Meter
- - - Denotes Mainline Pipe

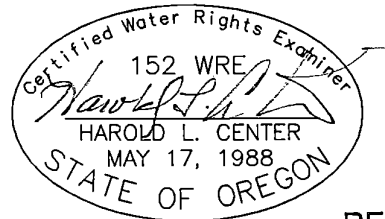

RECEIVED BY OWRD

Renews: 12-31-15

JUL 27 2015

This map was prepared for the purpose of identifying the location of a water right only and is not intended to provide legal dimensions or location of property ownership.

HAROLD L. CENTER
 2604 David Lane
 Medford, OR. 97504
 Phone 541-535-6108
 Oregon Certificate No. 152

SALEM, OR