


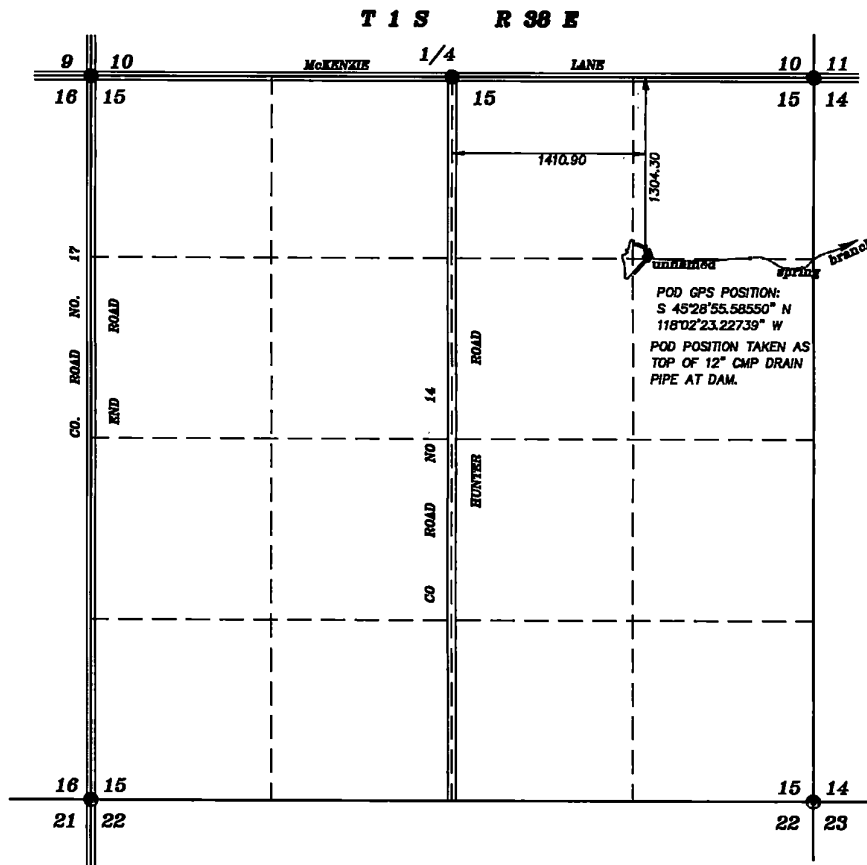


SCALE: 1"=1320'

Surface area of wildlife pond: 0.62 Ac.
Average depth 5'. Use 0.6 for silting = 1.86 Af.

RECEIVED BY OWRD

AUG 24 2015

SALEM, OR

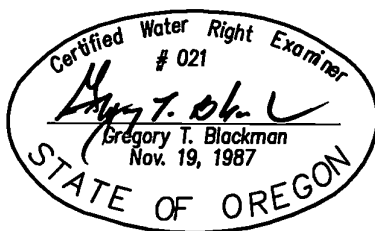

NOTE: The preparation of this map was for the purpose of identifying the location of the proposed water right and has no intent to provide dimensions or location of property ownership lines. Location information shown hereon was furnished by the applicant.

April 15, 2015
**CLAIM OF BENEFICIAL USE MAP
FOR STORING WATER UNDER
PERMIT R-12902**

FOR
Forrest Warren
BY

BAGETT - GRIFFITH & BLACKMAN
126 RIDGE DRIVE

LAGRANDE, OREGON 97850

Application No. R-84334

Permit Number R-12902