


This map is not intended to provide legal dimensions or locations of property ownership lines.

Legend

- Pond
- Property/DLC Lines
- PLSS



Final Proof Survey T10S R6W, W.M.

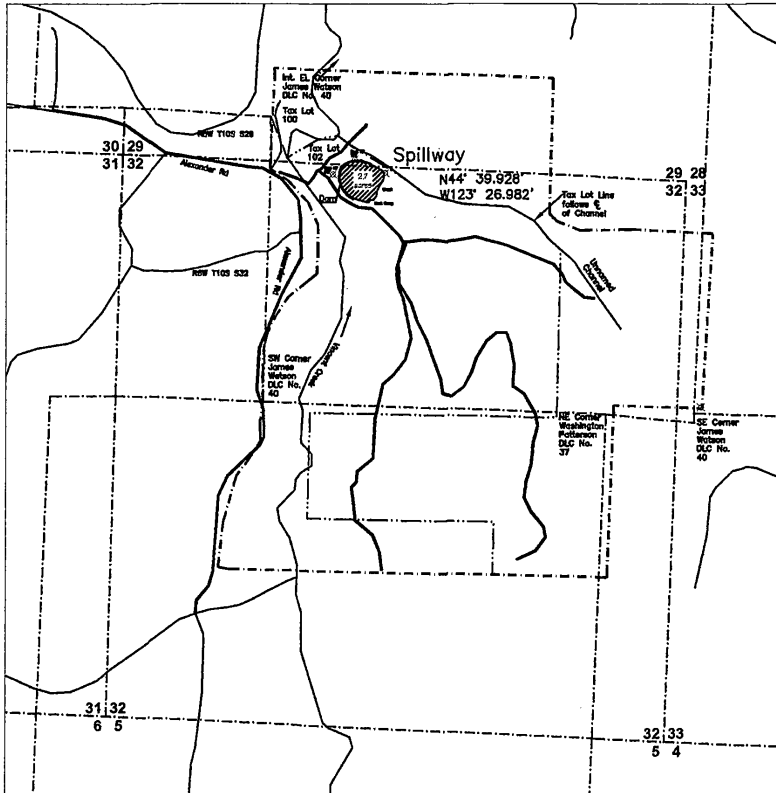

Claim of Beneficial Use

In the name of
**Sarah Ehlers
Living Trust**

Application # R-84973
Permit # R- 13200

Prepared by
**Walter L. Trimmer
CWRE #332
Trimmer Engineering Inc.
3924 NW Walnut Place
Corvallis, OR 97330
541-754-2819**

Scale 1" = 1320'

July 24, 2015
Layout: Pond
File: Ehlers.dwg
Based on USGS
Kings Valley Quad

RECEIVED BY OWRD

AUG 24 2015
SALEM, OR

DWG 1 of 1



Expires 6/30/2016