


T. 34 S., R. 5 W., W.M.

Sec. 17

SE 1/4 NE 1/4

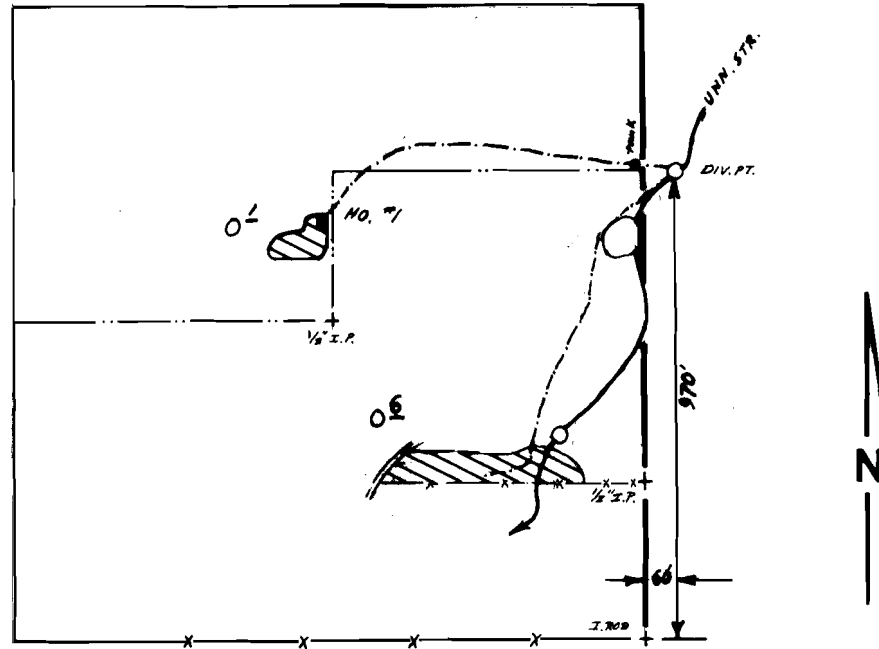

Scale 1" = 400'

FINAL PROOF SURVEY
UNDER

Application No. 55821.. Permit No. 41883.....
IN NAME OF

LESLIE HENNEUSE

Surveyed Oct... 8... 1984, by J.R. WOODROOF