


RECEIVED



ENR REVISIONS DEPT  
SALEM DIVISION

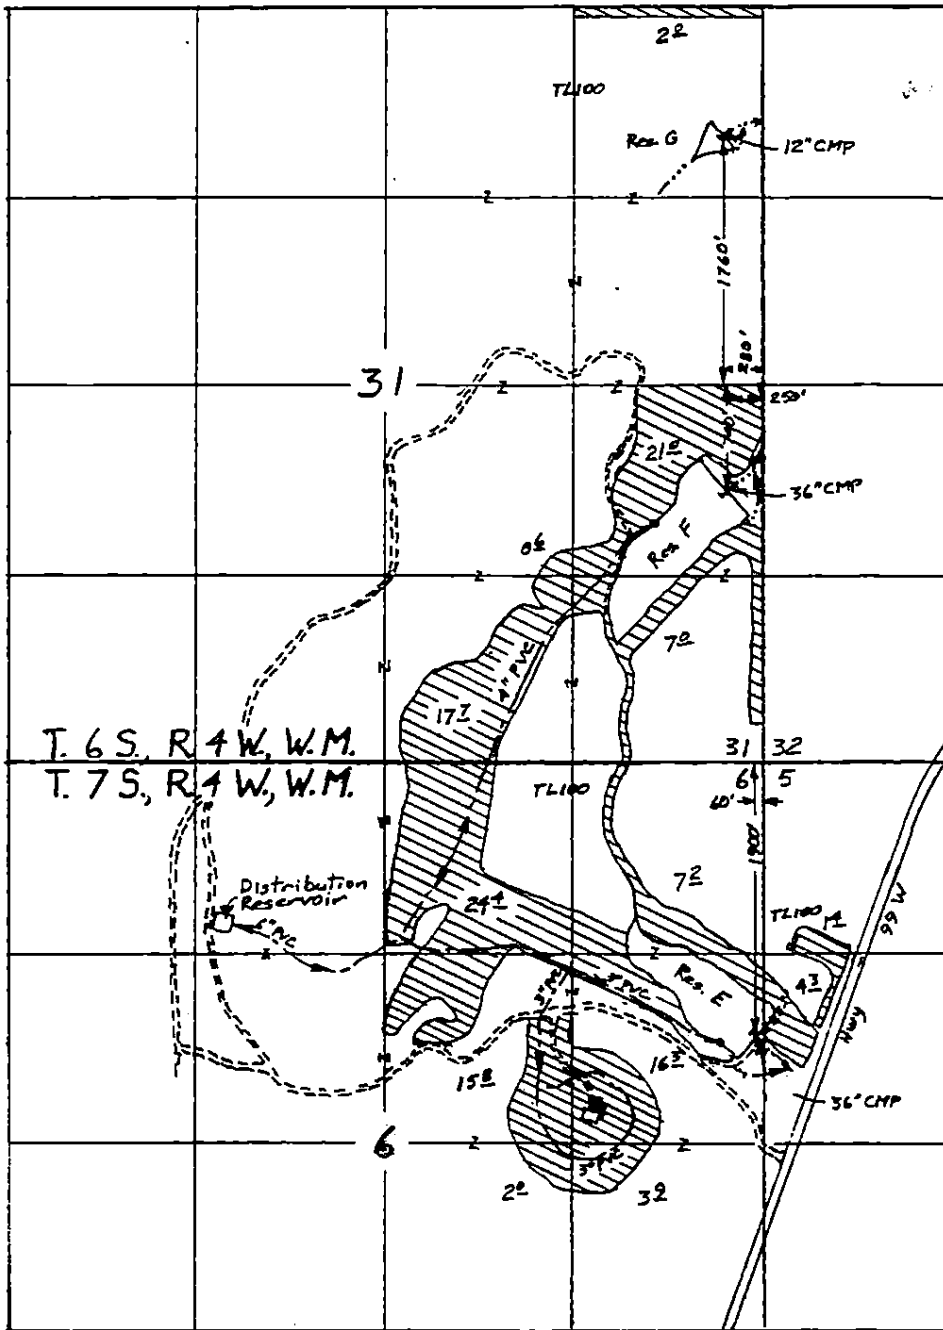


Scale 1"=1320'

Surveyed December 1, 1998

App R-72658, Per R-11498 & App. 72659, Per 51534

Claim of Beneficial Use Map  
for  
**CONRAD H. KONING**

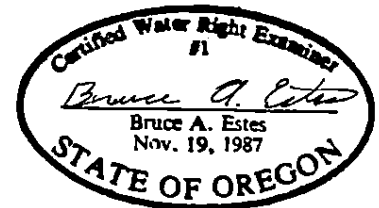

This map is for the purpose of  
locating a water right only  
and has no intent to provide  
legal dimensions or the location  
of property lines.

**ESTES SURVEYS**

6293 Sunnyview Rd. NE 60362 Arnold Rd.  
Salem, OR 97305 Bend, OR 97702  
(503) 585-7593 (503) 382-7391