





CLAIM OF BENEFICIAL USE MAP

TRANSFER T-8377

LOCATED IN SECTIONS 24 & 25,
TOWNSHIP 41 SOUTH, RANGE 13 WEST, W.M.
CURRY COUNTY, OREGON APPLICATION

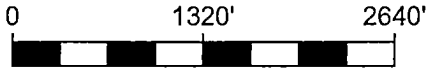

TRANSFERRED ACRES PER Q.Q. & SECTION	
Q.Q. & SECTION	ACRES
SE-SW SEC 24	3.8
SW-SE SEC 24	5.6
NW-NE SEC 25	3.6
NE-NW SEC 25	4.0
TOTAL	17.0

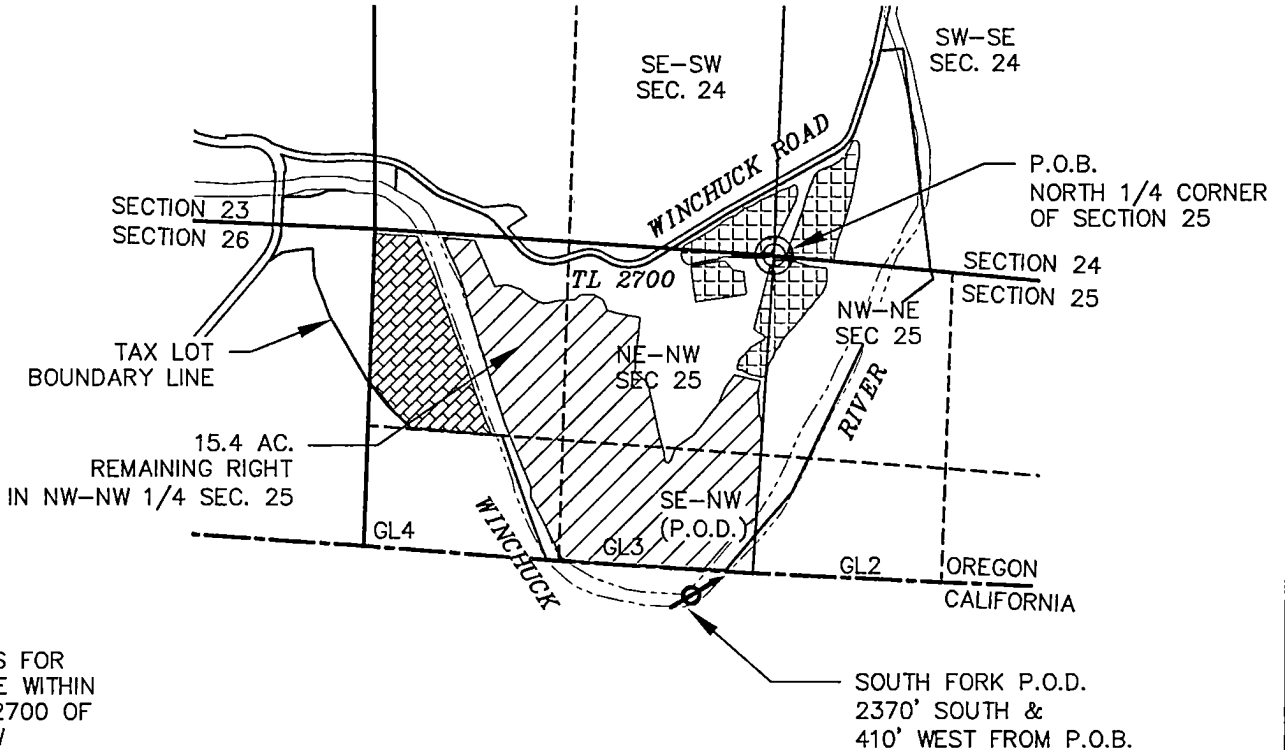

NOTE:
ALL LANDS FOR
T8377 ARE WITHIN
TAX LOT 2700 OF
T41S R13W

LEGEND

- POINT OF DIVERSION (P.O.D.)
- POINT OF BEGINNING (P.O.B.)
- AREA TRANSFERRED TO (17 AC.)
- AREA TRANSFERRED FROM (17 AC.)
- AREA UNCHANGED (CERTIFICATE 80415)
- Q-Q SECTION LINES
- GL# GOVERNMENT LOT

RECEIVED

OCT 18 2016

OWARD



EXPIRES 12/31/19

DISCLAIMER: THIS MAP WAS
PREPARED FOR THE PURPOSE
OF IDENTIFYING THE LOCATION
OF WATER RIGHT ONLY AND IS
NOT INTENDED TO PROVIDE
LEGAL DESCRIPTIONS OR
LOCATIONS OF PROPERTY LINES



705 S. 4TH ST.
P.O. BOX 118
COOS BAY, OREGON 97420

PHONE: (541) 267-2872
FAX: (541) 267-0588
www.stuntzner.com

Engineering - Land Surveying - Forestry - Land Planning - Water Rights

JOB #: 118-179

DATE: Sep 27, 2018

DRAWN BY: ABM

CHECKED BY: RED

PREPARED

FOR:

Lynne Dewald
99499 Winchuck River Rd
Brookings, OR 97415

FILE NAME: Water Right_Dewald.dwg

SHEET 1 OF 1