

THIS MAP IS NOT INTENDED TO PROVIDE LEGAL DIMENSIONS OR LOCATIONS OF PROPERTY OWNERSHIP LINES.

**COBU 1144 1 of 2**

Claim Map for T-10377, Township 18 S Range 2 W Section 25  
 Lane County Tax Lots 18-02-25-00-300, 303, 304, 305, 306, & 901


Original Point of Diversion						
Township	Range	Section	1/4	1/4 1/4	Glot	DLC
18S	2W	10	SW	NW	2	NA
1008 Feet S and 50 feet W of the NW corner of DLC 39						

Point of Diversion						
Township	Range	Section	1/4	1/4 1/4	Glot	DLC
18S	2W	25	NW	SW	8	NA
2350 Feet S and 1820 Feet W from the N 1/4 Corner of section 25						

Irrigation by 1/4 1/4, Glot, and DLC							
Township	Range	Section	1/4	1/4 1/4	Glot	DLC	Acerage
18S	2W	25	NE	SW	3	-	0.0496
18S	2W	25	NW	NE	1	-	1.3383
18S	2W	25	NW	NW	1	-	1.6904
18S	2W	25	NW	NW	9	52	4.6410
18S	2W	25	NW	NW	9	-	2.9691
18S	2W	25	NW	NW	-	-	2.1194
18S	2W	25	NW	SW	2	-	1.2778
18S	2W	25	NW	SW	8	52	7.2746
18S	2W	25	NW	SW	8	-	8.2485
18S	2W	25	NW	SW	-	-	1.2659
18S	2W	25	NW	SW	-	52	0.0434
18S	2W	25	NW	SE	2	-	18.1559
18S	2W	25	NW	SE	8	52	0.0014
18S	2W	25	NW	SE	8	-	1.0342
18S	2W	25	NW	SE	-	-	3.8355
18S	2W	25	SW	NE	7	-	0.0279
18S	2W	25	SW	NE	-	-	4.2312
18S	2W	25	SE	NW	3	-	3.9937
18S	2W	25	SE	NW	-	-	0.5432
Total							62.741

RECEIVED  
 JAN 28 2019  
 OWRD

COBU Map # 1144

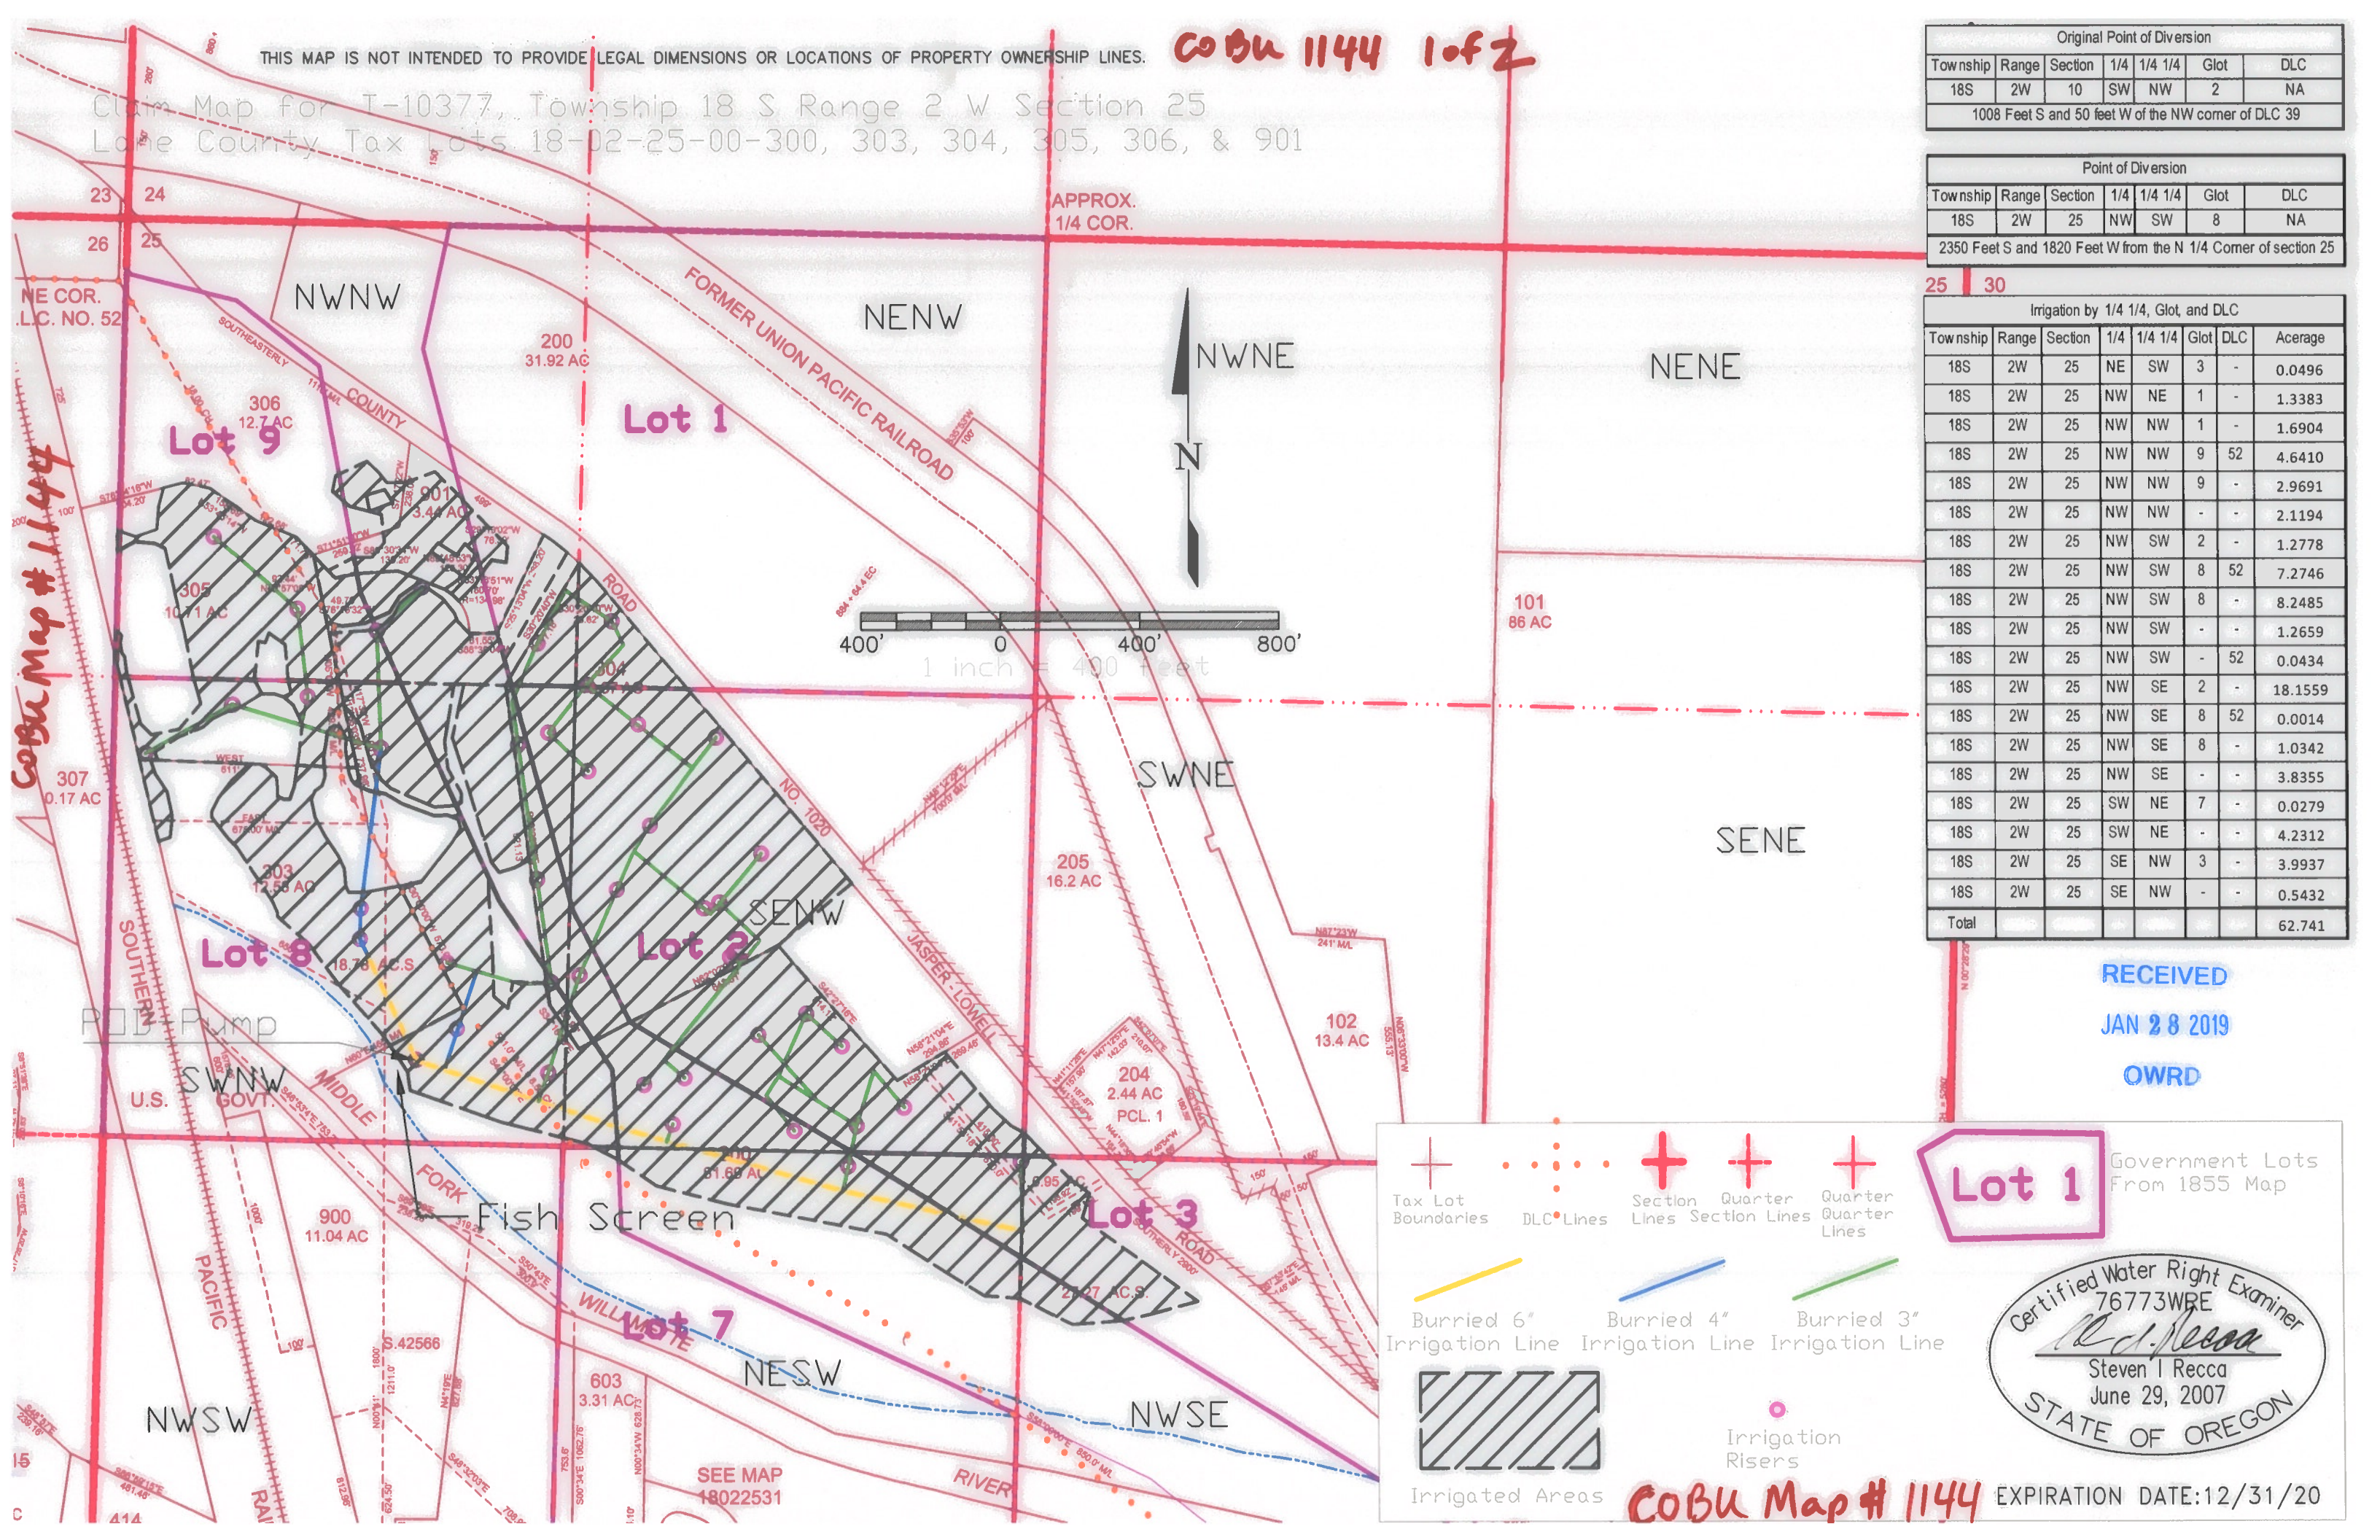

+ Tax Lot Boundaries  
••••• DLC Lines  
+ Section Lines  
+ Quarter Section Lines  
+ Quarter Quarter Lines  
— Burried 6" Irrigation Line  
— Burried 4" Irrigation Line  
— Burried 3" Irrigation Line  
 Irrigated Areas  
• Irrigation Risers

**Lot 1**

Government Lots From 1855 Map

COBU Map # 1144

EXPIRATION DATE: 12/31/20



SEE MAP 18022531

THIS MAP IS NOT INTENDED TO PROVIDE LEGAL DIMENSIONS OR LOCATIONS OF PROPERTY OWNERSHIP LINES.

Claim Map for T-10377, Township 18 S Range 2 W Section 25  
 Lane County Tax Lots 18-02-25-00-300, 303, 304, 305, 306, & 901

COBU 1144 2017

From Lands						
Township	Range	Section	1/4	1/4 1/4	Glott	Acerage
18S	2W	10	NE	SW		14.20
18S	2W	10	SE	NE		8.20
18S	2W	10	SE	NW		34.50
18S	2W	10	SE	SW		4.80
18S	2W	10	SE	SE		1.20
<b>Total</b>						<b>62.90</b>



From Lands Point of Diversion						
Township	Range	Section	1/4	1/4 1/4	Glott	
18S	2W	10	SW	NW	2	
1008 Feet S and 50 feet W of the NW corner of DLC 39						

To Lands by 1/4 1/4, Glott, and DLC							
Township	Range	Section	1/4	1/4 1/4	Glott	DLC	Acerage
18S	2W	25	NE	SW	3	-	0.0496
18S	2W	25	NW	NE	1	-	1.3383
18S	2W	25	NW	NW	1	-	1.6904
18S	2W	25	NW	NW	9	52	4.6410
18S	2W	25	NW	NW	9	-	2.9691
18S	2W	25	NW	NW	-	-	2.1194
18S	2W	25	NW	SE	2	-	18.1559
18S	2W	25	NW	SE	8	52	0.0014
18S	2W	25	NW	SE	8	-	1.0342
18S	2W	25	NW	SE	-	-	3.8355
18S	2W	25	NW	SW	2	-	1.2778
18S	2W	25	NW	SW	8	52	7.2746
18S	2W	25	NW	SW	8	-	8.2485
18S	2W	25	NW	SW	-	-	1.2659
18S	2W	25	NW	SW	-	52	0.0434
18S	2W	25	SE	NW	3	-	3.9937
18S	2W	25	SE	NW	-	-	0.5432
18S	2W	25	SW	NE	7	-	0.0279
18S	2W	25	SW	NE	-	-	4.2312
<b>Total</b>							<b>62.7409</b>

To Lands by 1/4 1/4, Glott, and Tax Lot									
Township	Range	Section	1/4	1/4 1/4	Tax Lot	Glott	Square Ft	Acerage	DLC
18S	2W	25	NW	NW	306	9	1280.6416	0.0294	
18S	2W	25	NW	NW	901	-	72062.1405	1.6543	
18S	2W	25	NW	NW	306	-	20099.4252	0.4614	
18S	2W	25	NW	NW	901	9	2692.8438	0.0618	
18S	2W	25	NW	NW	901	1	10662.4252	0.2448	
18S	2W	25	NW	NW	304	1	34953.9261	0.8024	
18S	2W	25	NW	NE	304	1	58294.2438	1.3383	
18S	2W	25	NW	NW	300	-	157.7431	0.0036	
18S	2W	25	NW	SW	305	8	57104.0947	1.3109	
18S	2W	25	NW	SW	305		1890.7830	0.0434	52
18S	2W	25	NW	SW	300	8	199929.7547	4.5898	
18S	2W	25	NW	SW	300	8	81917.7040	1.8806	52
18S	2W	25	NW	SW	300	8	96510.0492	2.2156	
18S	2W	25	NW	SW	304	2	55660.3644	1.2778	
18S	2W	25	NW	SE	304	2	495966.3671	11.3858	
18S	2W	25	NW	SW	303	8	234963.4030	5.3940	52
18S	2W	25	NW	SW	303	8	1133.8616	0.0260	
18S	2W	25	NW	SW	304	-	55144.5163	1.2659	
18S	2W	25	NW	SE	304	-	33625.4422	0.7719	
18S	2W	25	NW	SW	304	8	4627.4944	0.1062	
18S	2W	25	NW	SE	304	8	4600.3288	0.1056	
18S	2W	25	NW	SE	300	8	40447.4852	0.9285	
18S	2W	25	NW	SE	300	8	60.0651	0.0014	52
18S	2W	25	NW	SE	300	-	133448.7723	3.0636	
18S	2W	25	NW	SE	300	2	294903.0401	6.7700	
18S	2W	25	SW	NE	300	7	1214.1426	0.0279	
18S	2W	25	SW	NE	300	-	184309.0067	4.2312	
18S	2W	25	SE	NW	300	3	71320.5295	1.6373	
18S	2W	25	NE	SW	300	3	2162.3694	0.0496	
18S	2W	25	SE	NW	300	3	102646.4909	2.3564	
18S	2W	25	NW	NW	305	9	4154.7875	0.0954	
18S	2W	25	NW	NW	305	9	199297.0082	4.5752	52
18S	2W	25	NW	NW	300	9	121205.3059	2.7825	
18S	2W	25	NW	NW	300	9	2866.2253	0.0658	52
18S	2W	25	NW	NW	300	1	28018.0692	0.6432	
18S	2W	25	SE	NW	300	-	23663.7164	0.5432	
<b>Total</b>								<b>62.7409</b>	


To Lands Point of Diversion							
Township	Range	Section	1/4	1/4 1/4	Tax Lot	Glott	DLC
18S	2W	25	NW	SW	300	8	
2350 Feet S and 1820 Feet W from the N 1/4 Corner of section 25							

RECEIVED  
 JUL 09 2018  
 OWRD  
 NWNE  
 N

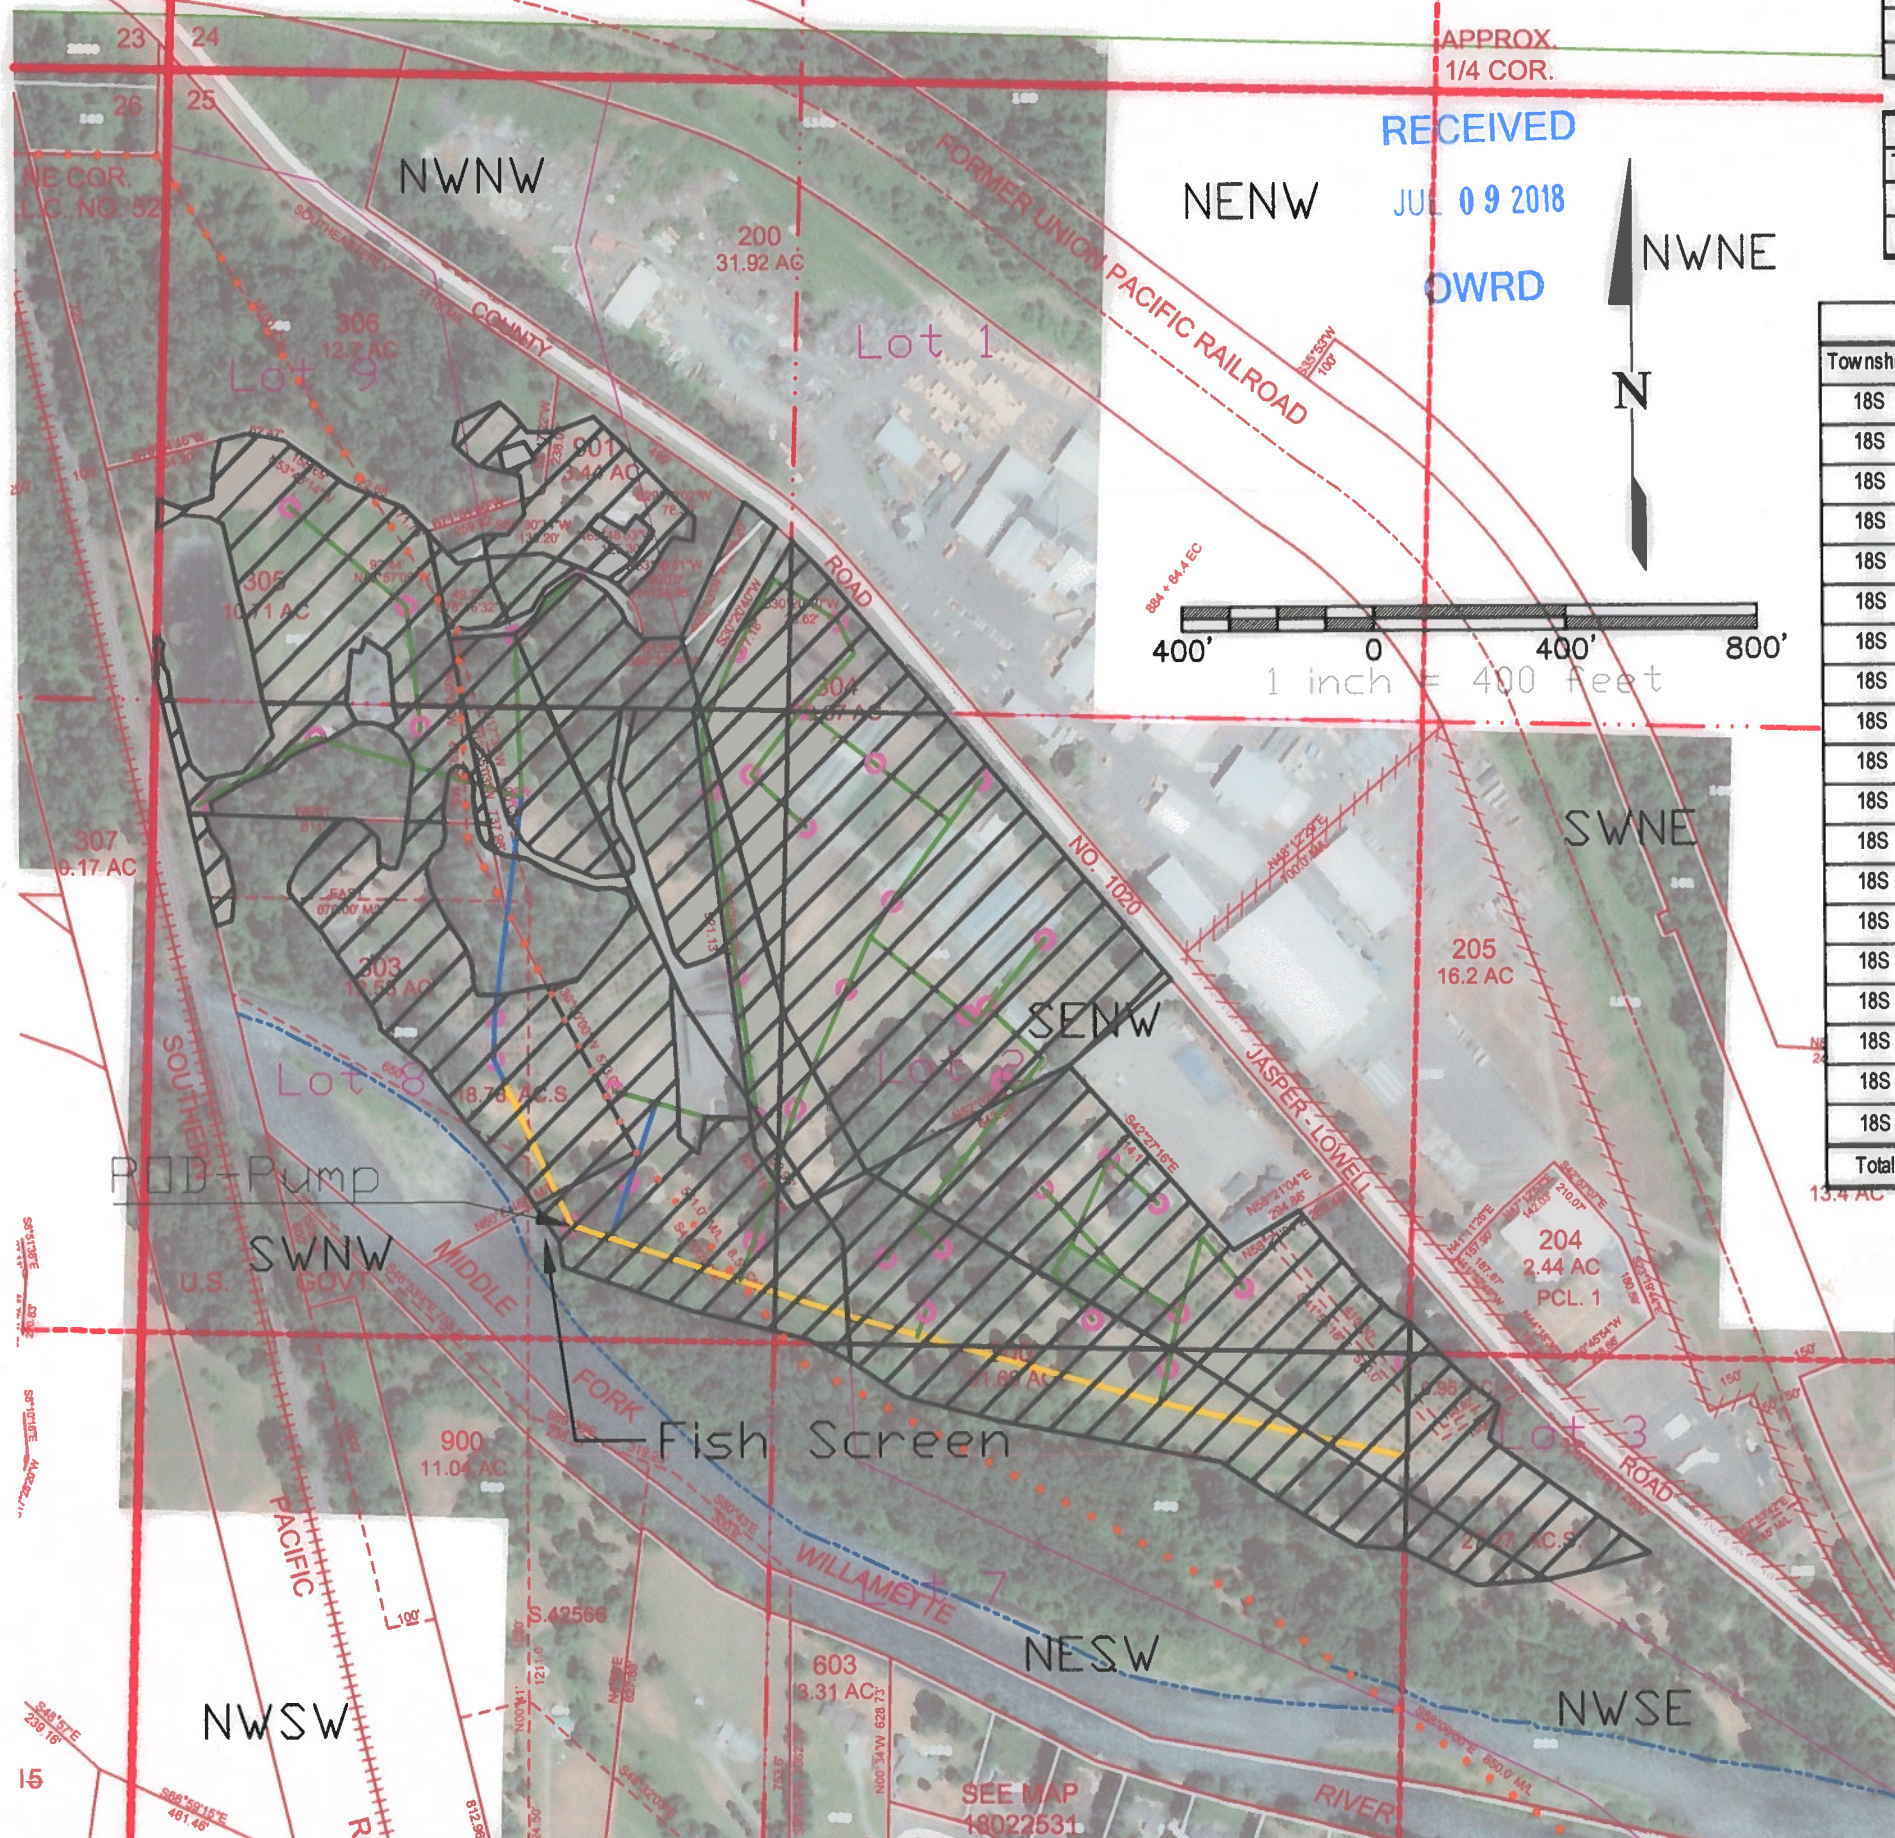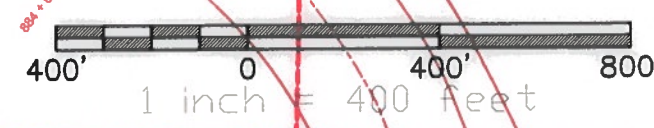

Tax Lot Boundaries  
 DLC Lines  
 Section Lines  
 Quarter Section Lines  
 Quarter Quarter Lines  
 Burried 6" Irrigation Line  
 Burried 4" Irrigation Line  
 Burried 3" Irrigation Line  
 Irrigated Areas  
 Irrigation Risers

Lot 1 Government Lots From 1855 Map

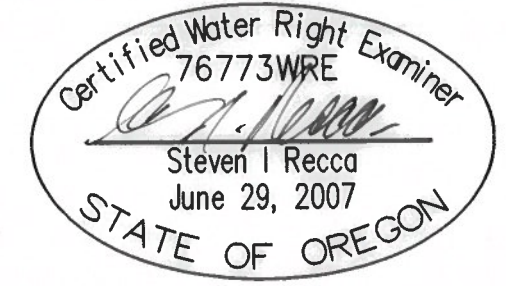

EXPIRATION DATE: 12/31/18

COBU 1144 2017