


RECEIVED

OCT 05 1998

WATER RESOURCES DEPT
SALEM, OREGON

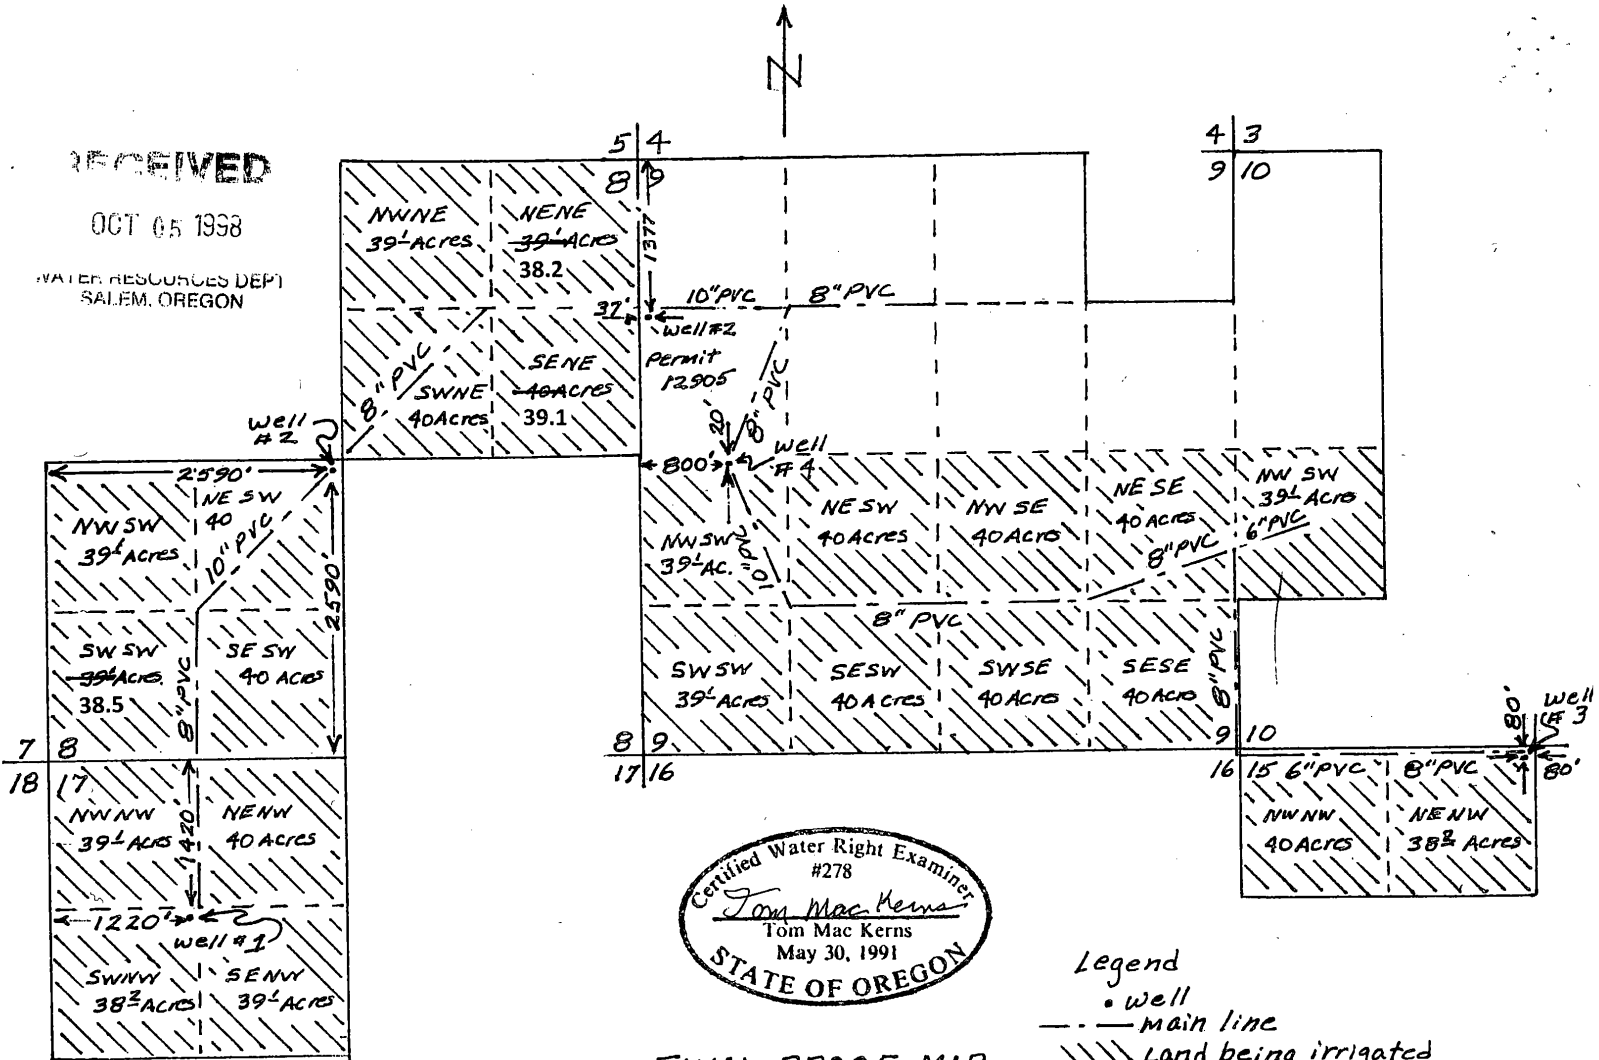

Certified Water Right Examiner
#278
Tom Mac Kerns
Tom Mac Kerns
May 30, 1991
STATE OF OREGON

Legend
 • well
 --- main line
 // Land being irrigated
 scale 4" = 1 mile
 Drawn 9-29-98 By TMK

FINAL PROOF MAP
 FOR PERMIT 12023
 T. 8 S.; R. 39 E.; W. M.