



FINAL PROOF MAP
FOR Permit G12887
and G12905

T.B.S.; R.39E.; W.M.

STATE OF OREGON
LAND RECORDS DIVISION

OCT 03 1991

RECEIVED

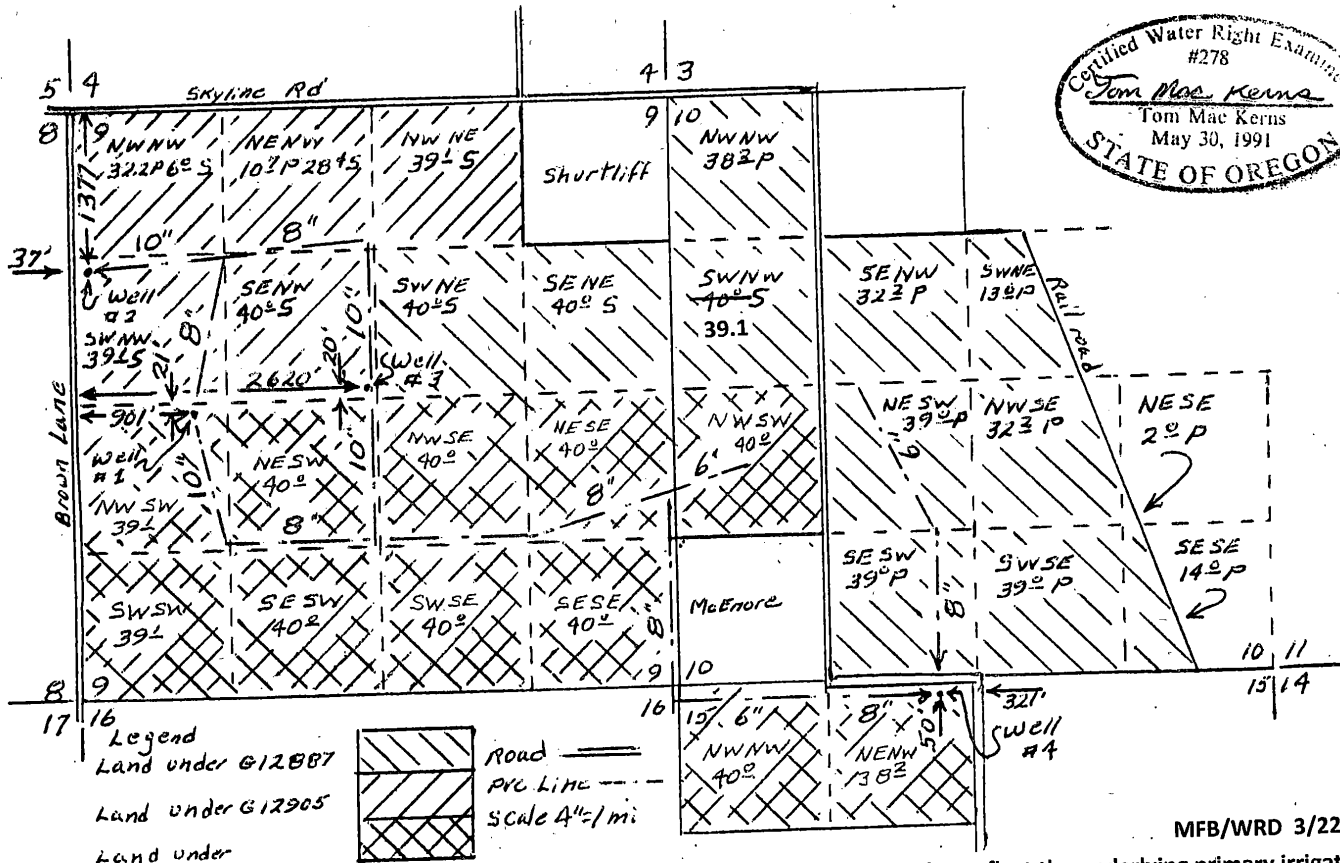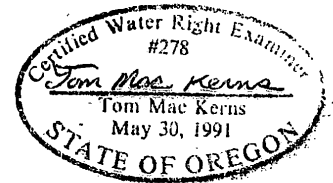

Legend
Land under G12887
Land under G12905
Land under
A.I.T. Division

Road
P.C. Line
Scale 4"=1 mi

This map has been revised by WRD. The acreage has been reduced to reflect the underlying primary irrigation.

MFB/WRD 3/22/18 MFB