
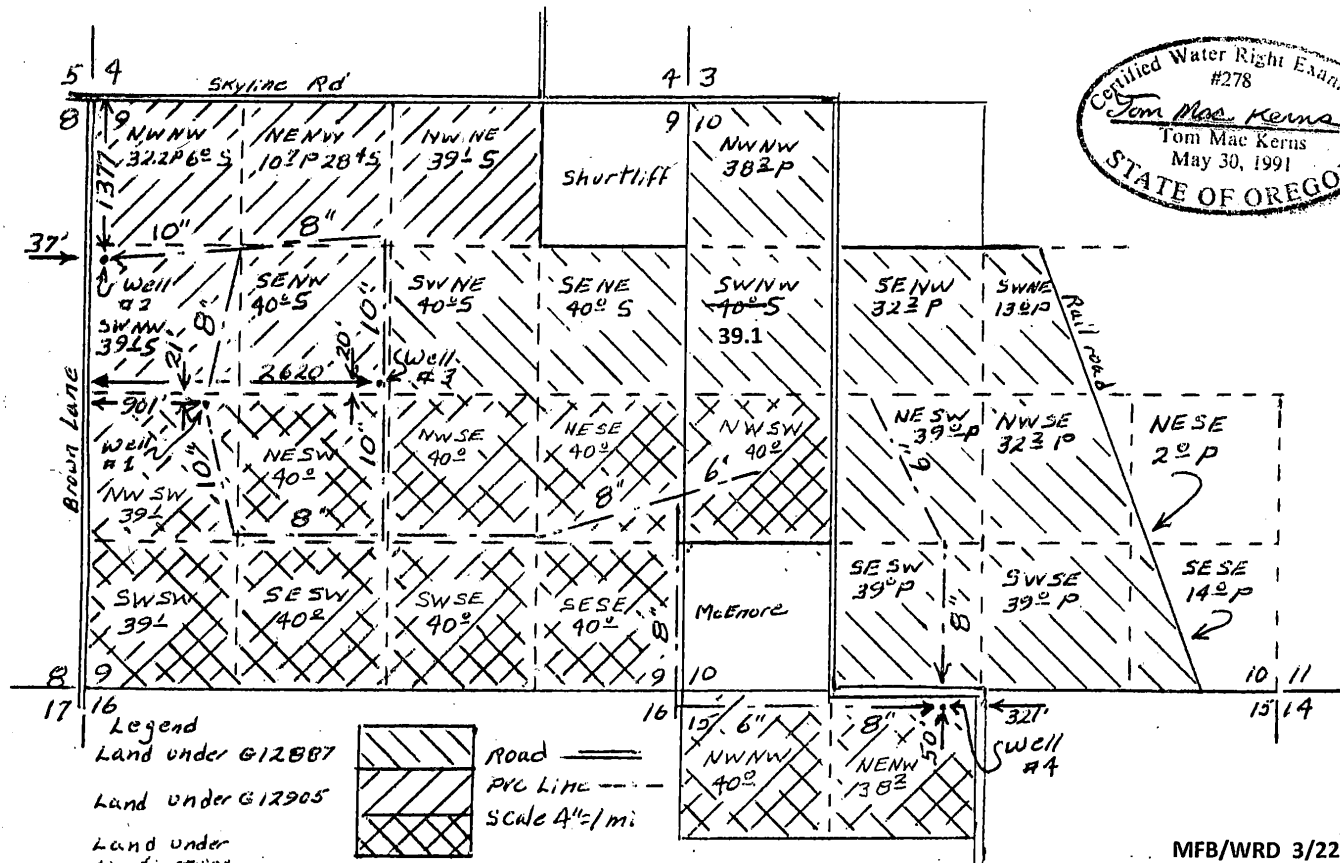


FINAL PROOF MAP
 FOR Permit G-12887
 and G-12905
 T.B.S.; R.39E.; W.M.

STATE OF OREGON
 DIVISION OF WATER RESOURCES

OCT 9 3 1991

RECEIVED

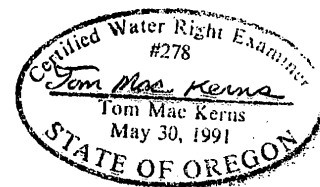

This map has been revised by WRD. The acreage has been reduced to reflect the underlying primary irrigation.

MFB/WRD 3/22/18 *MSB*