


T.3S. R.3W. Sec. 32 & 33 T.4S. R.3W. Sec. 4 & 5, W. M.

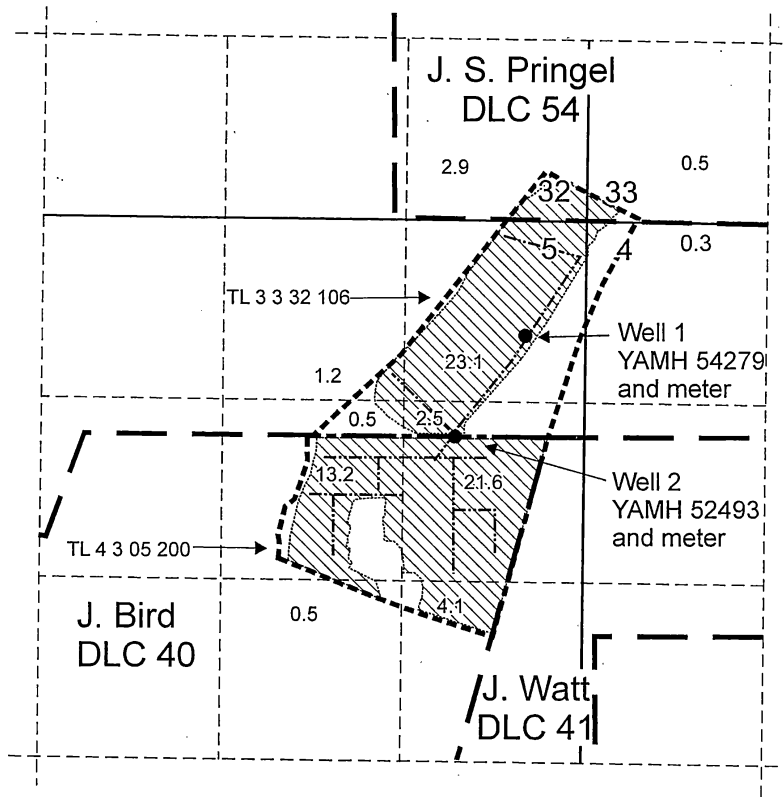

Well 1 is located 830 feet south and 450 feet west from the NE corner of Section 5.


Well 2 is located 10 feet south and 680 feet west from the NE corner of J. Bird DLC 40.

- Area (70.4 Acres) irrigated under Application G-15122, Permit G-15331
- Tax lot boundary
- Irrigation Mainline



DATE: 6/30/11

Scale: 1" = 1,320'

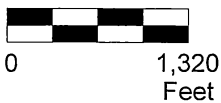

This map was prepared for the purpose of identifying the location of a water right only and is not intended to provide legal dimensions or location of property ownership lines.



Pacific Hydro-Geology Inc.

Claim of Beneficial Use Map
Application G-15122, Permit G-15331

Humphreys Roepenack Inc.
T.3S. R.3W. Sec. 32 & 33 and
T.4S. R.3W. Section 4 & 5, W.M.

11/10-bg