



FINAL PROOF MAP

IN THE NAME OF MATLOCKS GREENHOUSES INC.
Application G-16171 Permit G-15812
T 5 S, R 2 W, W.M. Section 25

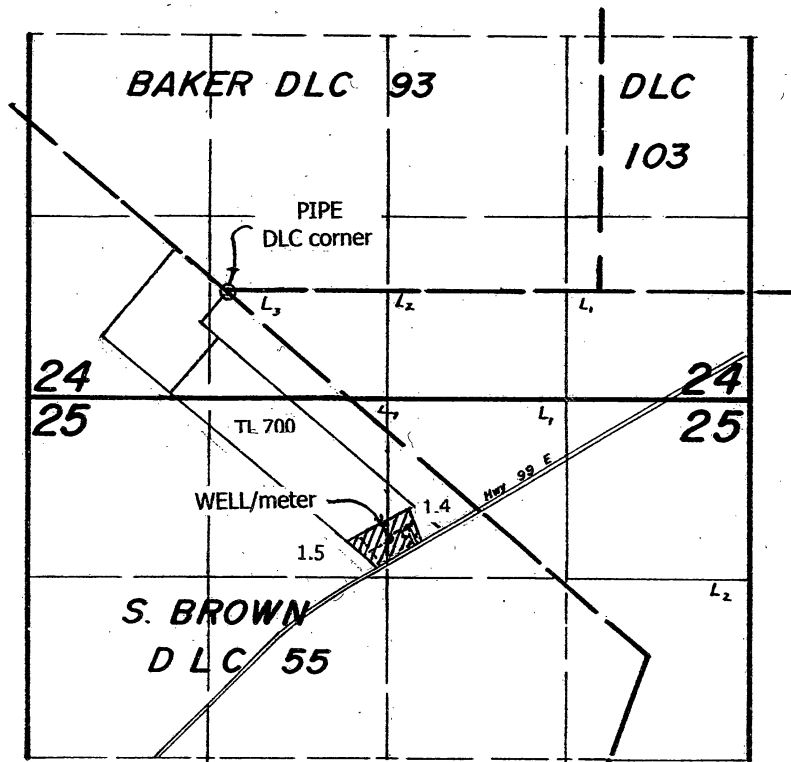

DLC line
Section line
Pipe line
Tax Lot Boundary
1/4 1/4 line

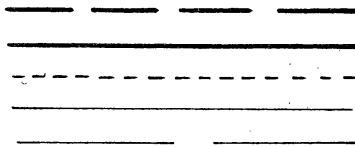


RECEIVED

SEP 27 7

RESOURCE
ALEX, OREGON

DIVERSION POINT: 1810' S & 1195' E
from the SW Corner DLC 93

Scale 1" = 1320'

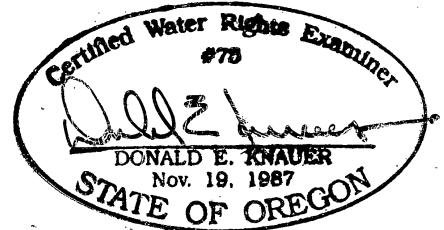

RENEWAL DATE: 6-30-2011

This map is not intended to provide legal dimensions or locations of property ownership lines.