

CLAIM OF BENEFICIAL USE MAP FOR
WESLEY K. NELSON AND DUSTINE D. NELSON
LOCATED IN PORTION OF THE


SE 1/4 OF SEC 24, T 8. N, R 4. W, W.M.
AND IN A PORTION OF THE SW 1/4 OF SEC 19
T 8. N, R ~~3~~4. W, W.M., COLUMBIA, OREGON

UNDER PERMIT NO. S-53580 AND APPLICATION NO. S-83908
IN THE NAME OF WESLEY K. NELSON AND DUSTINE D. NELSON
SITE VISIT MARCH 24, 2015
BY MINISTER AND GLAESER SURVEYING, INC



RECEIVED BY OWRD

OCT 29 2015

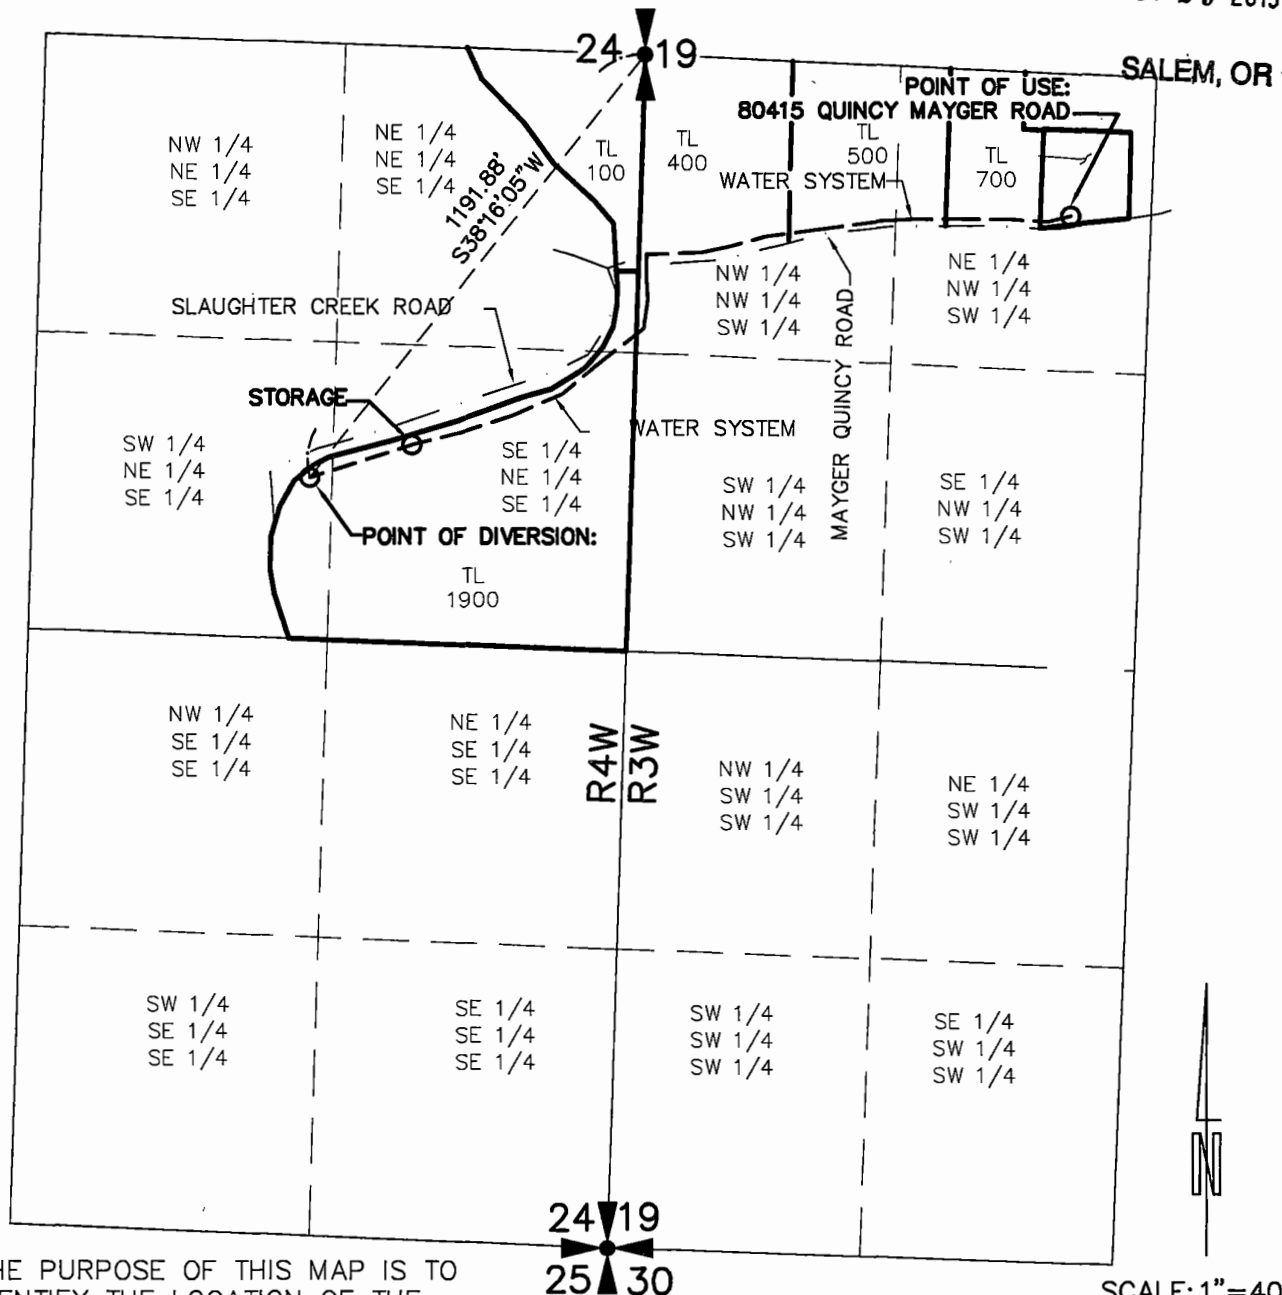

THE PURPOSE OF THIS MAP IS TO
IDENTIFY THE LOCATION OF THE
WATER RIGHT. IT IS NOT INTENDED TO
PROVIDE INFORMATION RELATIVE TO
THE LOCATION OF PROPERTY
OWNERSHIP BOUNDARY LINES.

POINT OF DIVERSION IS S38°16'05"W, 1191.88 FEET
FROM THE NW CORNER OF THE SW 1/4 OF SEC 19,
T 8. N, R 3. W, W.M., COLUMBIA COUNTY, OREGON