


Final Proof Survey


Transfer No. 12528

Pat Voigt / Ricco Ranch
Township 11 South, Range 35 East, Sections 21 & 28 W.M.

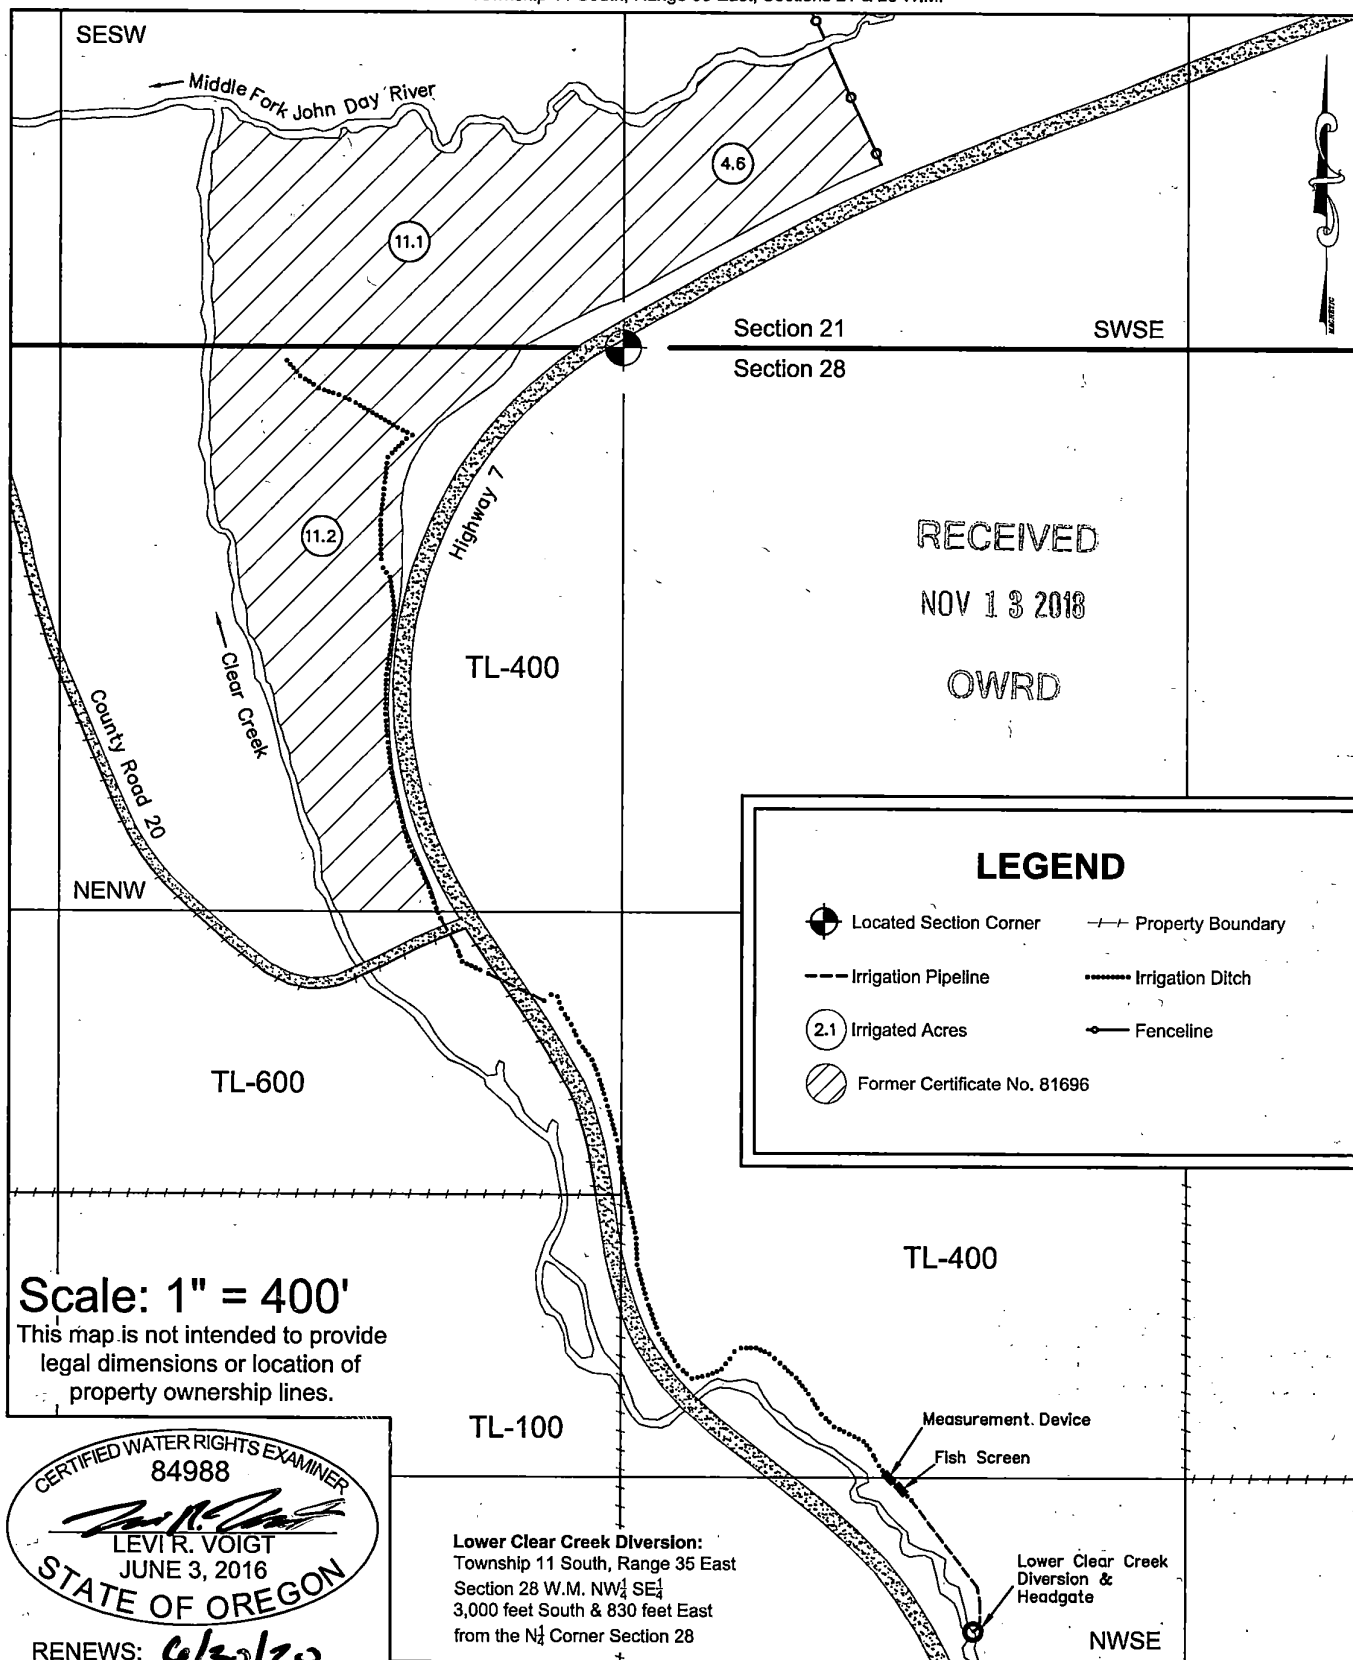

Scale: 1" = 400'

This map is not intended to provide
legal dimensions or location of
property ownership lines.

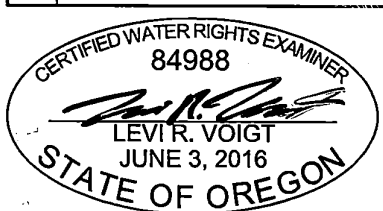

RENEWS: 6/30/20

Lower Clear Creek Diversion:
Township 11 South, Range 35 East
Section 28 W.M. NW $\frac{1}{4}$ SE $\frac{1}{4}$
3,000 feet South & 830 feet East
from the N $\frac{1}{4}$ Corner Section 28

Lower Clear Creek
Diversion &
Headgate

NWSE