


COBU MAP FOR TRANSFER T-12451  
 IN THE NAME OF DAVE DEMARIS  
 SEC 24, T6N, R34E, W.M., UMATILLA COUNTY

24

NE1/4SW1/4  
 SEC 24

NW1/4SE1/4  
 SEC 24

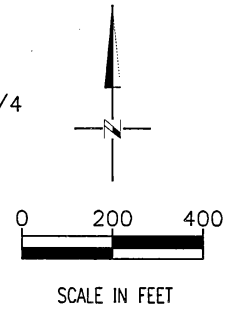

TL 400

TL 401

TL 400

SE1/4SW1/4  
 SEC 24

TL 900

TL 1000

TL 800

Buried Pipeline  
 Typical

TL 700

SW1/4SE1/4  
 SEC 24

14.0  
 AC

New POA, (New Well) w/  
 10 hp submersible pump  
 450'N & 100'W from the  
 South 1/4 Cor Sec 24

Valve and Meter  
 House, Location of  
 flow meter.

UMAPINE ROAD

S1/4 COR  
 SEC 24


RECEIVED

NOV 09, 2018

LEGEND



AREA IRRIGATED

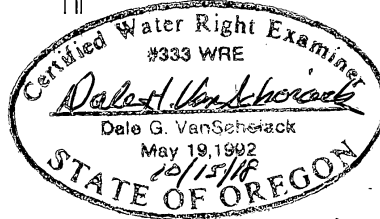

OWRD

DGV Consulting, PLLC  
 PHONE (509) 627-8717  
 dalevconsulting@gmail.com  
 Date: Oct 15, 2018

NOTE:  
 THE PURPOSE OF THIS MAP IS TO IDENTIFY THE APPROXIMATE LOCATION OF THE WATER  
 RIGHT. IT IS NOT INTENDED TO PROVIDE INFORMATION RELATIVE TO THE LOCATION OF  
 PROPERTY OWNERSHIP BOUNDARY LINES. PIPELINE SIZES AND LOCATIONS WERE  
 PROVIDED BY FARM PERSONNEL AND HAVE NOT BEEN VERIFIED.