


# Certificate Map

Township 34 South, Range 2 West, Section 16, W.M.

Jackson County, Oregon

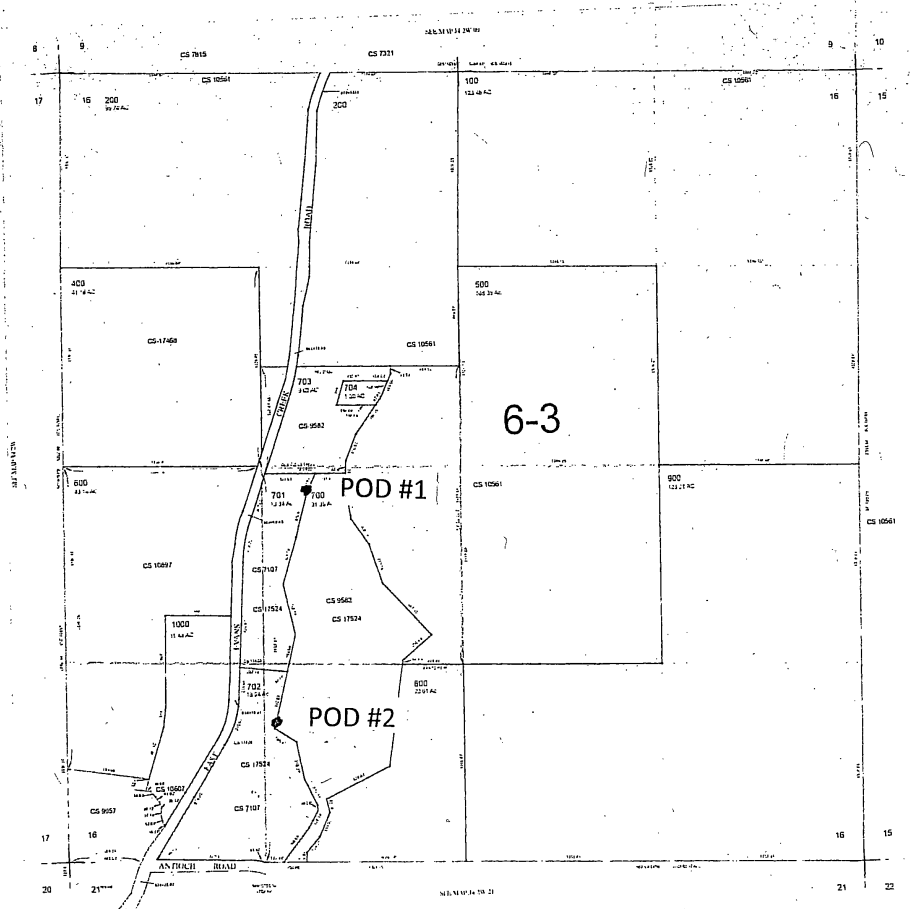

Scale 1 inch = 1320 feet

POD #1 – 150 Feet South and 1050 Feet West From Center  $\frac{1}{4}$  Corner

POD #2 – 1750 Feet South 1300 Feet West From Center  $\frac{1}{4}$  Corner

Map based on WRD Aerial Photo 41029-279 268-R and Jackson County Assessor Map 34 2W 16

*This map is not intended to provide legal dimensions or locations of property ownership lines*

3/12/2019  
WRD

SE 1/4 NW 1/4

NW 1/4 SW 1/4

ROGUE RIVER DECREE  
16152  
T-4650, CT. 37310  
1889

Imperial  
NE 1/4 SW 1/4  
POD

(10<sup>ac</sup>)  
(1888)

TRANSFER  
2403  
CERT.  
43571

20, AC

SW 1/4 SW 1/4

SE 1/4 SW 1/4  
POD

SW SW

Imperial