

FINAL PROOF SURVEY
UNDER PERMIT NO. G-15484
APPLICATION NO. G-15909


IN NAME OF
LOU WILLIAM DAVIES & MARY JOSEPHINE DAVIES

BY

ROBERT D. BAGETT
217 N. CANYON BLVD.
JOHN DAY, OREGON
(541) 575-1251

DATE SURVEYED: MAY 17, 2011

SCALE: 1" = 1320'

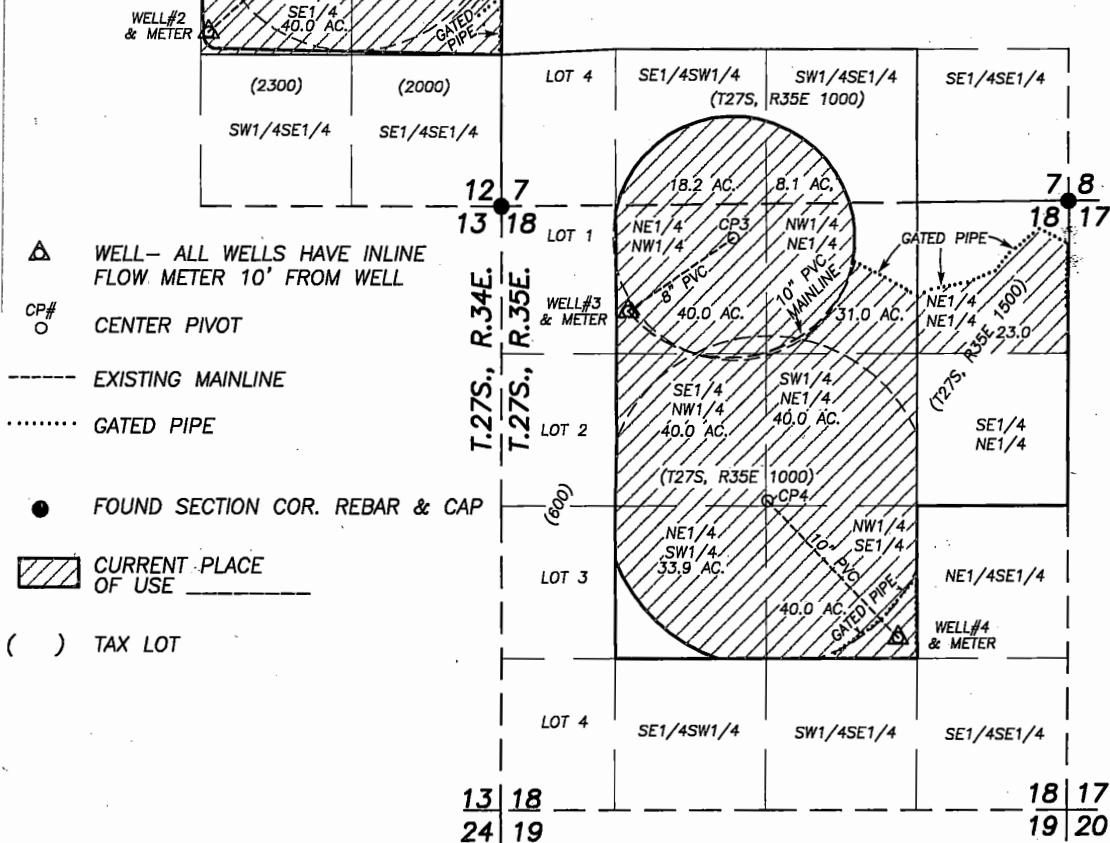

WELL #1 IS 3990 FT. NORTH AND 2430 FT. WEST FROM THE SE COR. SEC. 12, T.27S., R.34E.
WELL #2 IS 1515 FT. NORTH AND 2575 FT. WEST FROM THE SE COR. SEC. 12, T.27S., R.34E.
WELL #3 IS 910 FT. SOUTH AND 1110 FT. EAST FROM THE NW COR. SEC. 18, T.27S., R.35E.
WELL #4 IS 3780 FT. SOUTH AND 1490 FT. WEST FROM THE NE COR. SEC. 18, T.27S., R.35E.

COBU MAP # 0614
folder S

NOTE: THE PREPARATION OF THIS MAP WAS FOR THE PURPOSE OF IDENTIFYING THE LOCATION OF THE PROPOSED WATER RIGHT AND HAS NO INTENT TO PROVIDE DIMENSIONS OR LOCATION OF PROPERTY OWNERSHIP LINES.

