


COBU MAP # 938

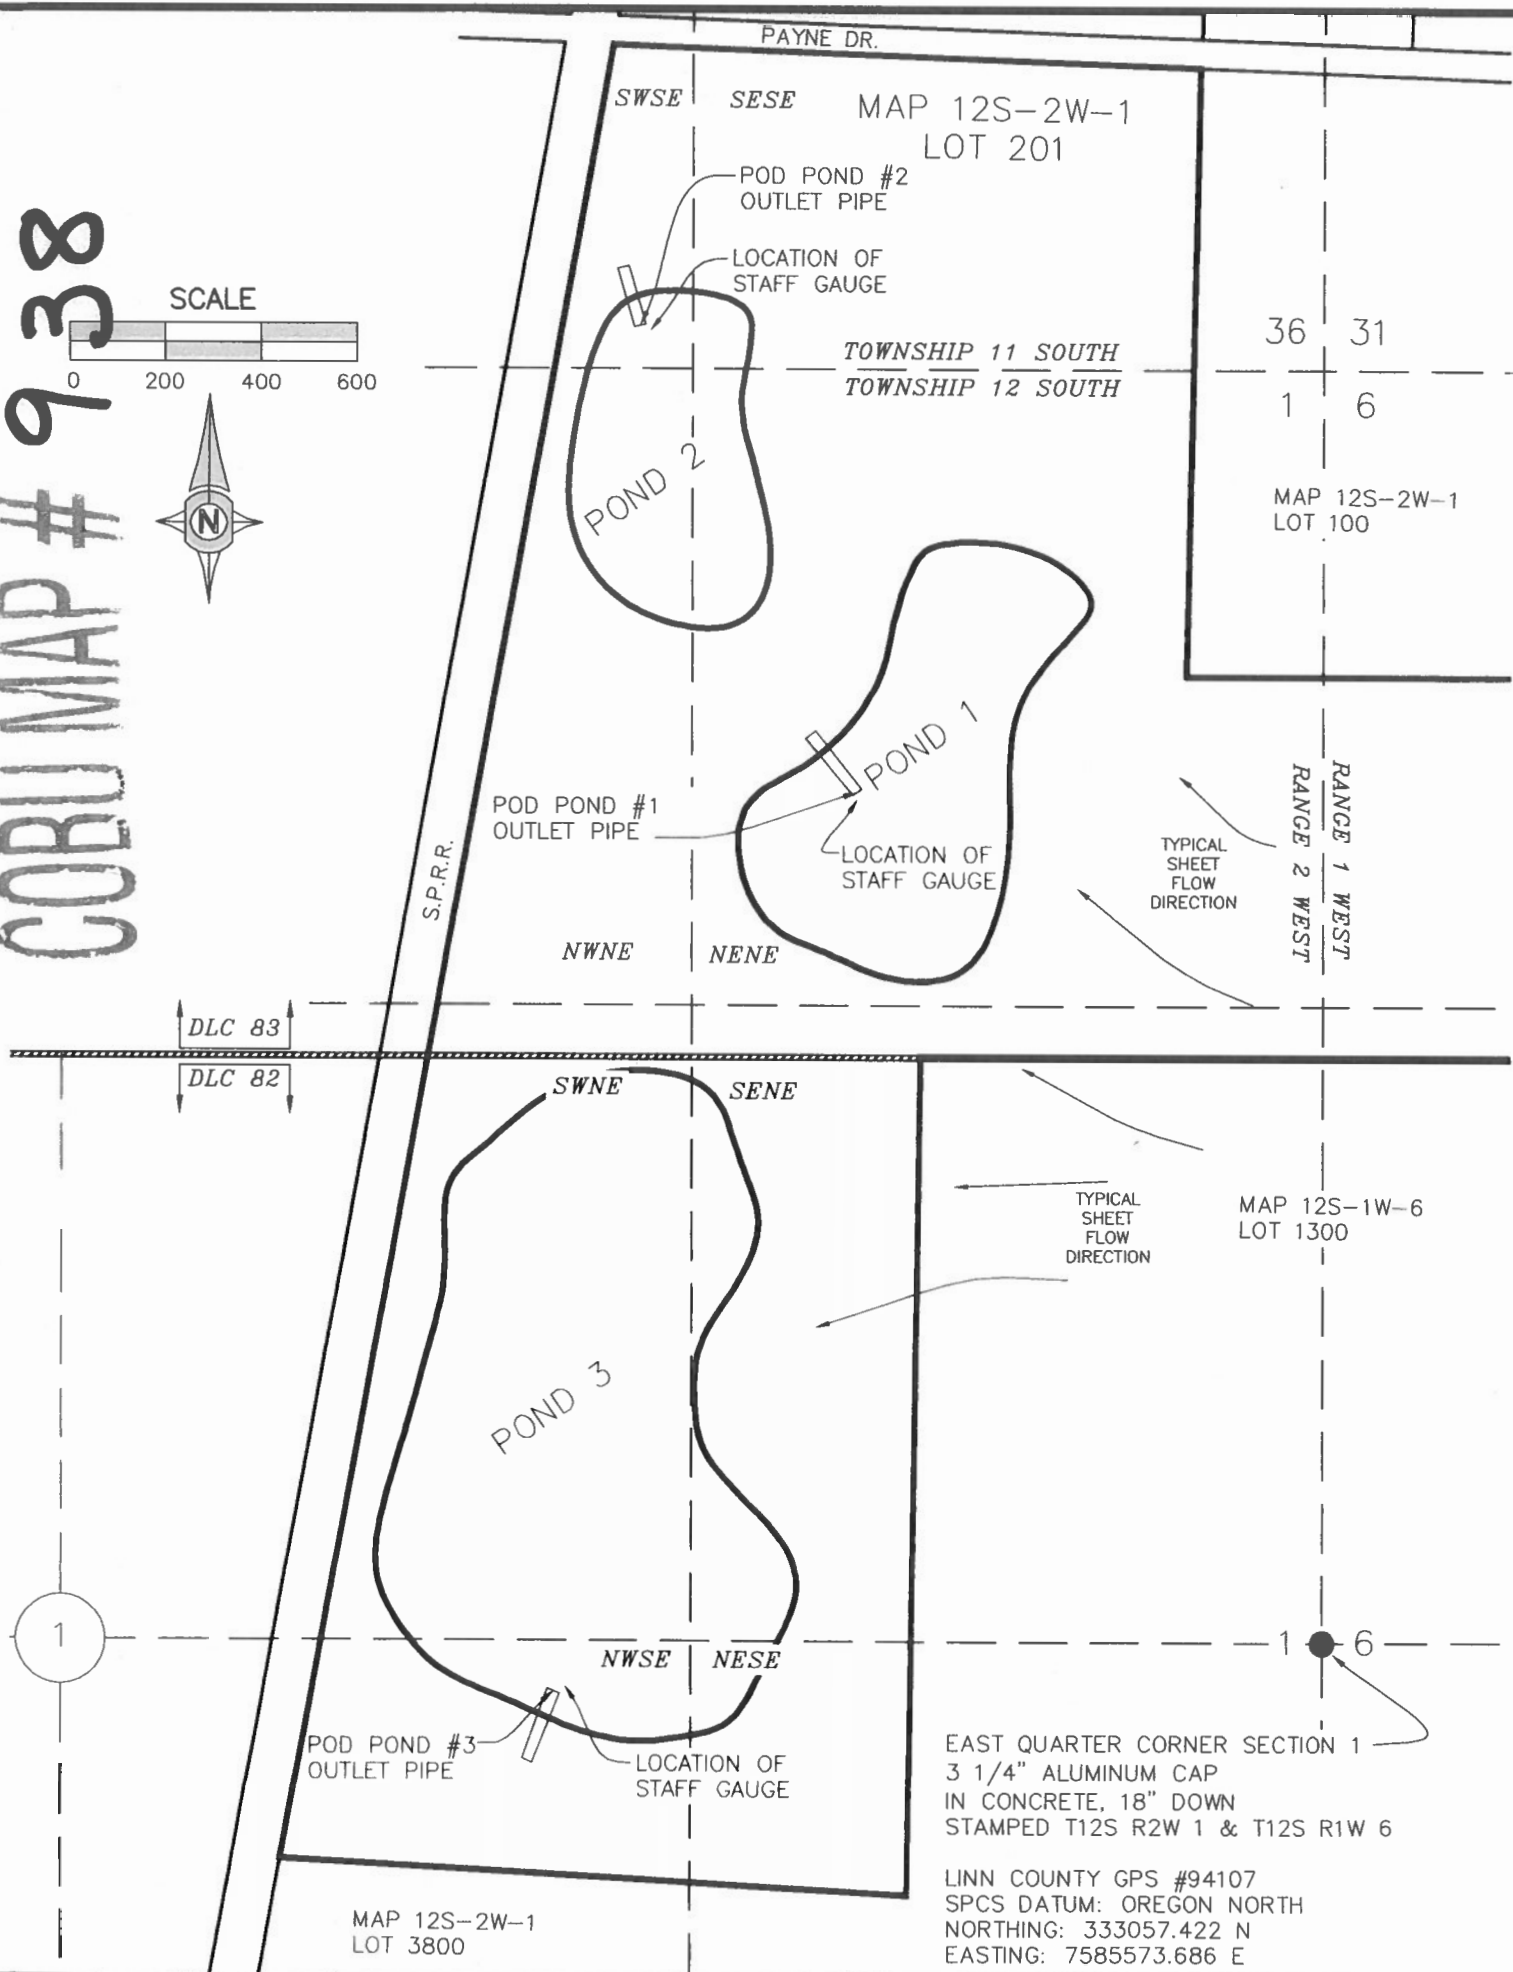

CLAIM OF BENEFICIAL USE MAP  
FOR ALTON SULLIVAN

LOCATED IN SECTION 36, TOWNSHIP 11 SOUTH, RANGE 2 WEST &  
SECTION 1, TOWNSHIP 12 SOUTH, RANGE 2 WEST, W.M.,  
LINN COUNTY, OREGON  
ONE HORSE SLOUGH MITIGATION BANK, POND 1, 2 AND 3  
SEPTEMBER 09, 2015

POND #1  
APPLICATION R-86627, PERMIT R-14334  
LOCATED IN THE NE1/4NE1/4 SECTION 1, TOWNSHIP 12 SOUTH, RANGE 2 WEST, W.M.  
POINT OF DIVERSION: 900 FEET SOUTH AND 1000 FEET WEST FROM THE NORTHEAST  
CORNER OF SECTION 1, TOWNSHIP 12 SOUTH, RANGE 2 WEST, W.M.  
NORTHING: 334820.25  
EASTING: 7584597.27

POND #2  
APPLICATION R-86628, PERMIT R-14335  
LOCATED IN THE SW1/4SE1/4 SECTION 36, TOWNSHIP 11 SOUTH, RANGE 2 WEST, W.M.  
AND THE NW1/4NE1/4 SECTION 1, TOWNSHIP 12 SOUTH, RANGE 2 WEST, W.M.  
POINT OF DIVERSION: 100 FEET NORTH AND 1400 FEET WEST FROM THE NORTHEAST  
CORNER OF SECTION 1, TOWNSHIP 12 SOUTH, RANGE 2 WEST, W.M.  
NORTHING: 335786.57  
EASTING: 7584142.55

POND #3  
APPLICATION R-86629, PERMIT R-14336  
LOCATED IN THE SW1/4NE1/4, SE1/4SE1/4, NW1/4SW1/4  
AND THE NE1/4SE1/4 SECTION 1, TOWNSHIP 12 SOUTH, RANGE 2 WEST, WM.  
POINT OF DIVERSION: 100 FEET SOUTH AND 1600 FEET WEST FROM THE EAST QUARTER  
CORNER OF SECTION 1, TOWNSHIP 12 SOUTH, RANGE 2 WEST, W.M.  
NORTHING: 332952.18  
EASTING: 7583964.90

NOTE  
THIS MAP IS NOT INTENDED TO PROVIDE LEGAL DIMENSIONS OR LOCATIONS OF PROPERTY  
OWNERSHIP LINES.

PROPERTY LINES ARE BASED ON DATA OF RECORD AND AERIAL PHOTOGRAPHS. ALL  
DISTANCE ARE APPROXIMATE.

LEGEND  
POD POINT OF DIVERSION  
DLC DONATION LAND CLAIM

RECEIVED  
SEP 25 2015

WATER RESOURCES DEPT  
SALEM, OREGON

CERTIFIED WATER RIGHT EXAMINER  
#71593  
Brenda J. James  
BRENDA J. JAMES  
JUNE 17, 2014  
STATE OF OREGON  
EXPIRES: 6/30/2017  
9/17/2015

CLIENT:  
ALTON SULLIVAN  
6001 NW GILMOUR LANE  
ALBANY, OREGON

UDELL ENGINEERING &  
LAND SURVEYING, LLC  
63 EAST ASH ST.  
LEBANON, OREGON 97355  
(541) 451-5125 PH.  
(541) 451-1366 FAX

ONE HORSE SLOUGH  
CLAIM OF  
BENEFICIAL USE MAP  
LINN COUNTY, OREGON

data 09/14/15  
project  
drawn by  
checked by