


COBU MAP # 938

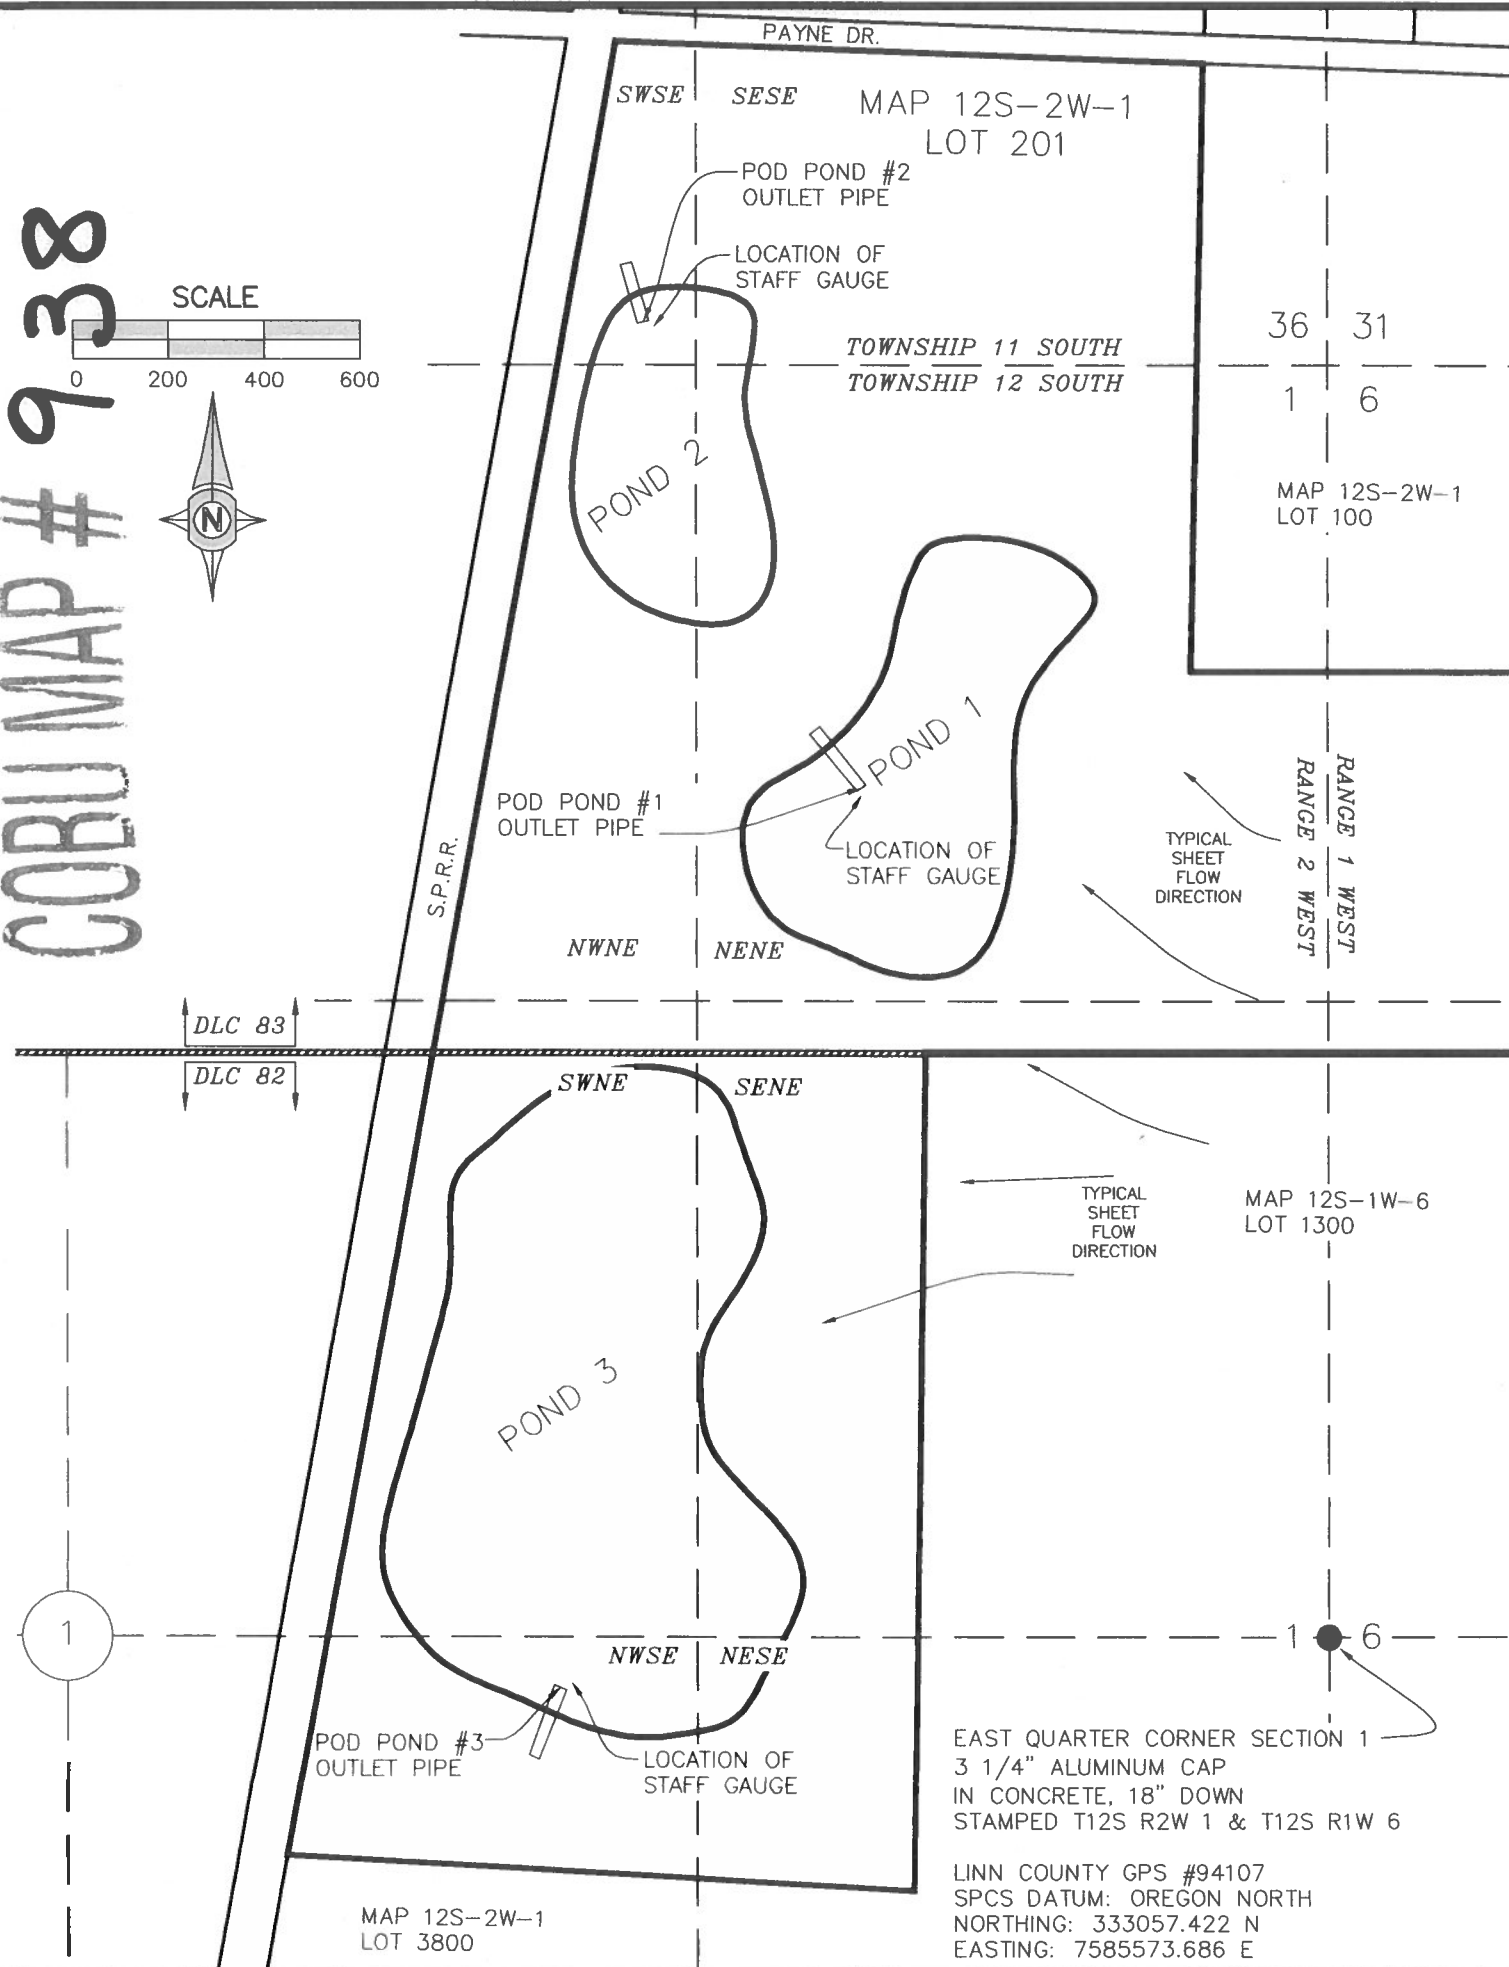

CLAIM OF BENEFICIAL USE MAP FOR ALTON SULLIVAN

LOCATED IN SECTION 36, TOWNSHIP 11 SOUTH, RANGE 2 WEST &
SECTION 1, TOWNSHIP 12 SOUTH, RANGE 2 WEST, W.M.,
LINN COUNTY, OREGON
ONE HORSE SLOUGH MITIGATION BANK, POND 1, 2 AND 3
SEPTEMBER 09, 2015

POND #1
APPLICATION R-86627, PERMIT R-14334
LOCATED IN THE NE 1/4 NE 1/4 SECTION 1, TOWNSHIP 12 SOUTH, RANGE 2 WEST, W.M.
POINT OF DIVERSION: 900 FEET SOUTH AND 1000 FEET WEST FROM THE NORTHEAST
CORNER OF SECTION 1, TOWNSHIP 12 SOUTH, RANGE 2 WEST, W.M.
NORTHING: 334820.25
EASTING: 7584597.27

POND #2
APPLICATION R-86628, PERMIT R-14335
LOCATED IN THE SW 1/4 SE 1/4 SECTION 36, TOWNSHIP 11 SOUTH, RANGE 2 WEST, W.M.
AND THE NW 1/4 NE 1/4 SECTION 1, TOWNSHIP 12 SOUTH, RANGE 2 WEST, W.M.
POINT OF DIVERSION: 100 FEET NORTH AND 1400 FEET WEST FROM THE NORTHEAST
CORNER OF SECTION 1, TOWNSHIP 12 SOUTH, RANGE 2 WEST, W.M.
NORTHING: 335786.57
EASTING: 7584142.55

POND #3
APPLICATION R-86629, PERMIT R-14336
LOCATED IN THE SW 1/4 NE 1/4, SE 1/4 SE 1/4, NW 1/4 SW 1/4
AND THE NE 1/4 SE 1/4 SECTION 1, TOWNSHIP 12 SOUTH, RANGE 2 WEST, W.M.
POINT OF DIVERSION: 100 FEET SOUTH AND 1600 FEET WEST FROM THE EAST QUARTER
CORNER OF SECTION 1, TOWNSHIP 12 SOUTH, RANGE 2 WEST, W.M.
NORTHING: 332952.18
EASTING: 7583964.90

NOTE
THIS MAP IS NOT INTENDED TO PROVIDE LEGAL DIMENSIONS OR LOCATIONS OF PROPERTY
OWNERSHIP LINES.


PROPERTY LINES ARE BASED ON DATA OF RECORD AND AERIAL PHOTOGRAPHS. ALL
DISTANCE ARE APPROXIMATE.

LEGEND
POD POINT OF DIVERSION
DLC DONATION LAND CLAIM

RECEIVED

SEP 25 2015

WATER RESOURCES DEPT
SALEM, OREGON

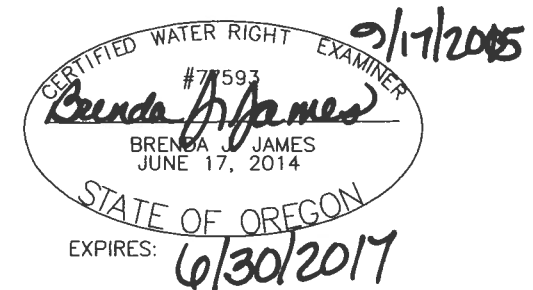

CLIENT:

UDELL ENGINEERING &
LAND SURVEYING, LLC

ALTON SULLIVAN
6001 NW GILMOUR LANE
ALBANY, OREGON

63 EAST ASH ST.
LEBANON, OREGON 97355
(541) 451-5125 PH.
(541) 451-1366 FAX

ONE HORSE SLOUGH
CLAIM OF
BENEFICIAL USE MAP
LINN COUNTY, OREGON

date 09/14/15
project
drawn by
checked by

SHEET 1
OF 1
SCALE: SEE BARSCALE